


T.5S., R.6W., W.M.

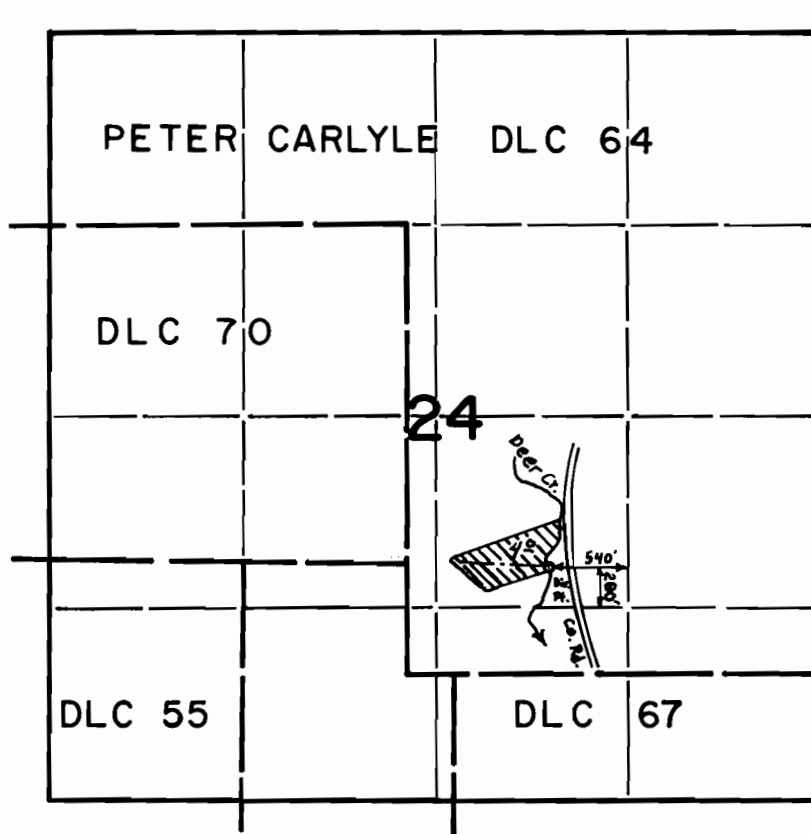

FINAL PROOF SURVEY
UNDER

Application No. 52962 Permit No. 39982
IN NAME OF

JOHN EDWARD EVERS

Surveyed AUG. 3 1976, by D. NORBY