


T.5S., R.7W., W.M.

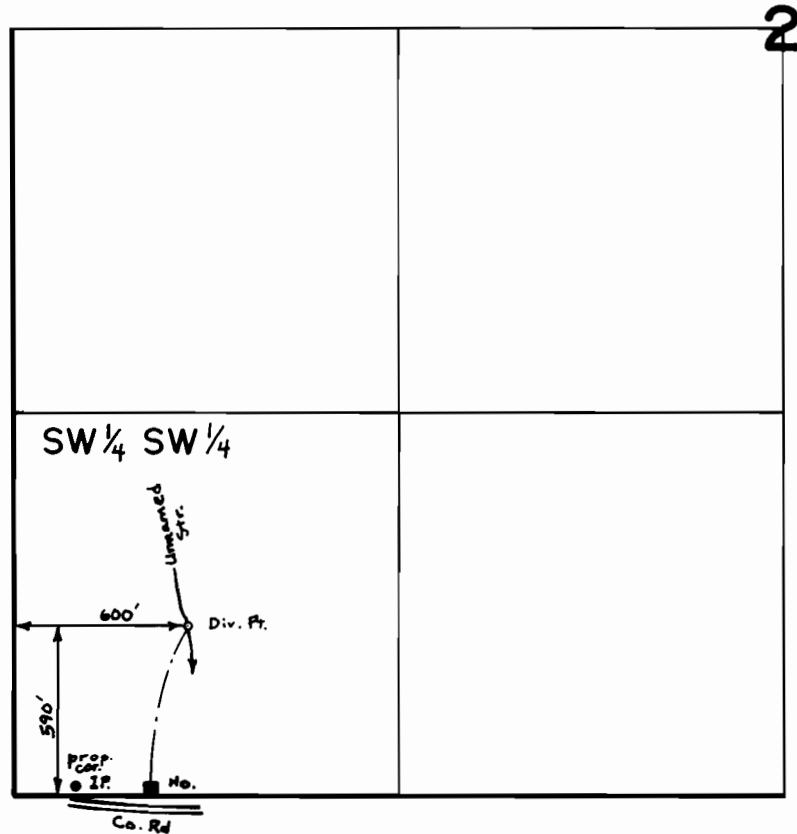

SCALE : 1" = 660'

FINAL PROOF SURVEY
UNDER

Application No. 52989 Permit No. 39997
IN NAME OF

LEONARD M. HOSMER

Surveyed AUG. 5 19 76, by D. NORBY