


T.5S., R.7W., W.M.

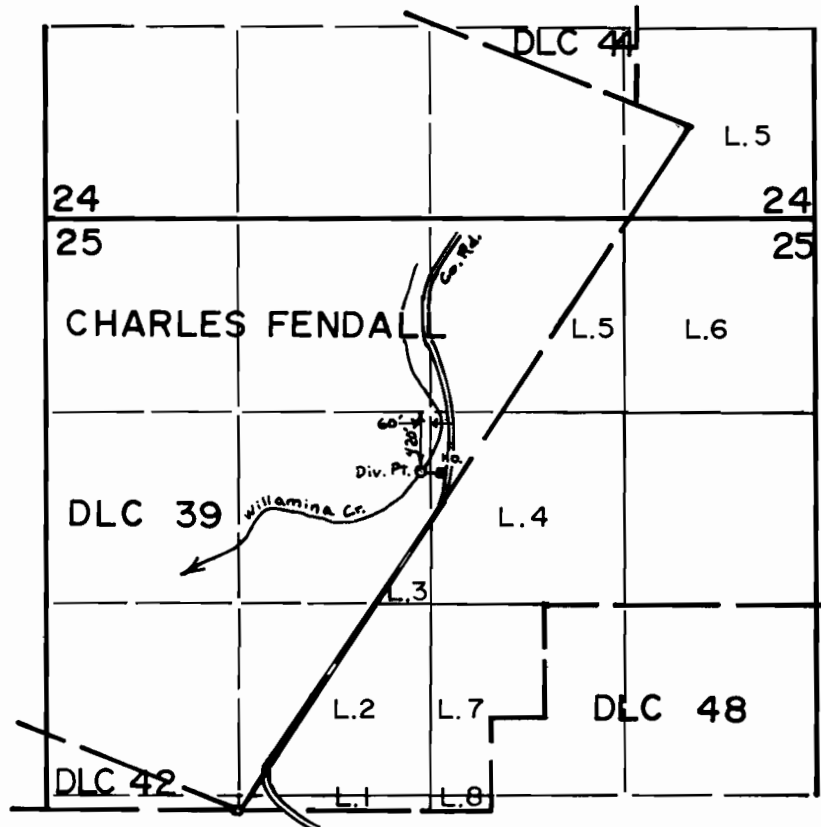

**FINAL PROOF SURVEY**  
UNDER

Application No. 52994 Permit No. 40001  
IN NAME OF

DAN MATOCHA

Surveyed AUG. 6 1976, by D. NORBY