


T.6S., R.8W., W.M.

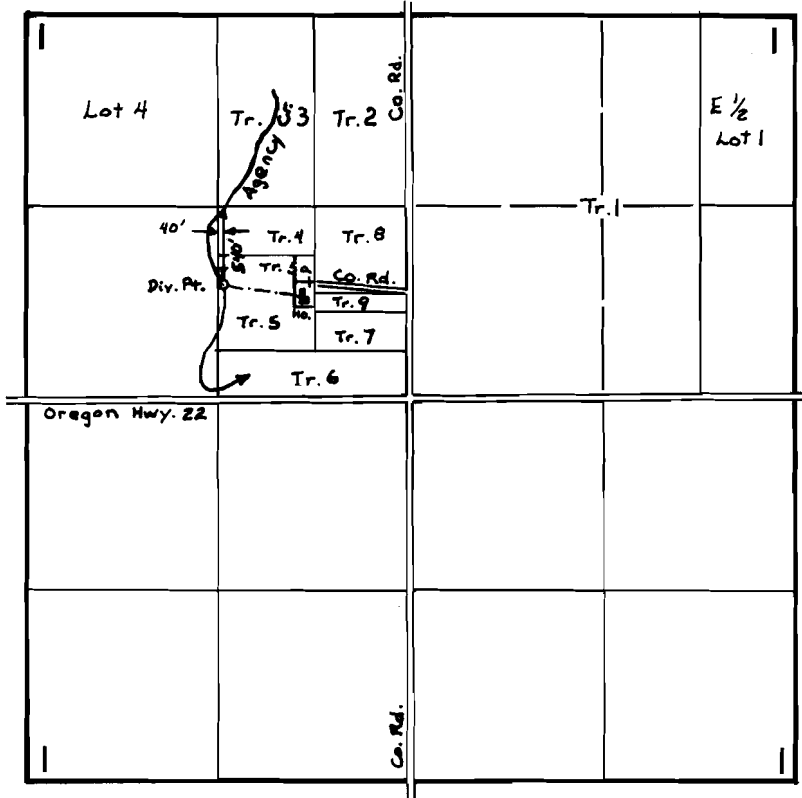

FINAL PROOF SURVEY UNDER

Application No. 53057 Permit No. 40038
IN NAME OF

VERNA R. LARSEN

Surveyed AUG. 5 1976, by D. NORBY