


RECEIVED

MAR 31 1976

WATER RESOURCES DEPT
SALEM, OREGON

T. 3 S. R. 4 W. W. M.

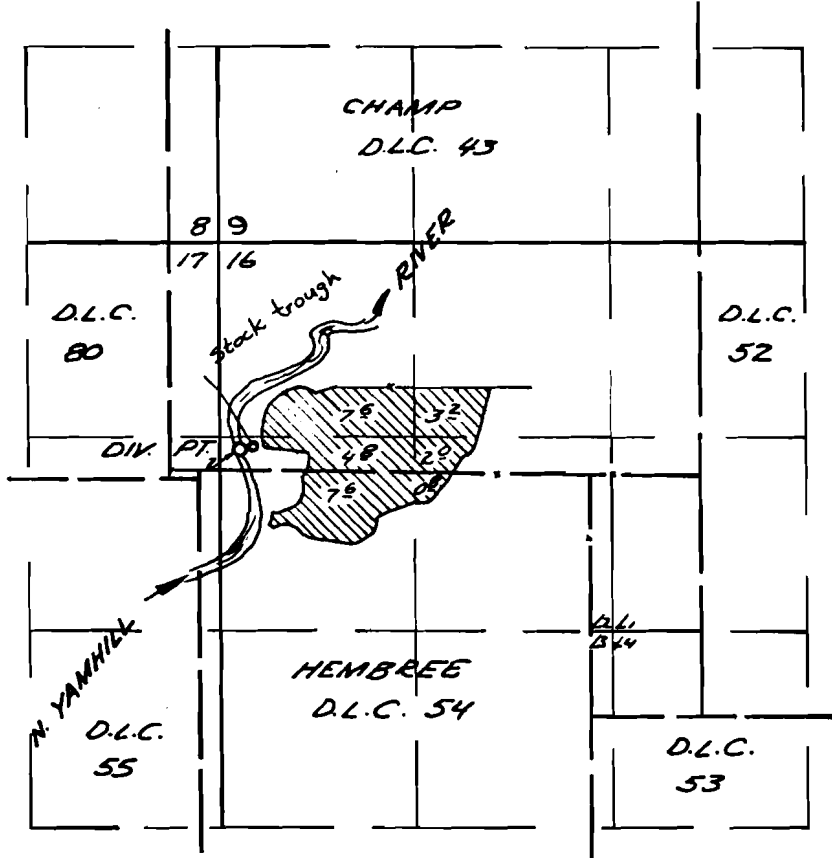

Div. Pt. located 160 ft. N. and 2390 ft. W. from
the N.E. corner of Hembree D.L.C. # 54

FINAL PROOF SURVEY
UNDER

Application No. 38653. Permit No. 28934
IN NAME OF

HARVEY C. GERMAN

Surveyed Oct. 19, 1967, by V. Garner

Application No. 53978

Permit No. 40256