


T.3S.,R.1W.,W.M.

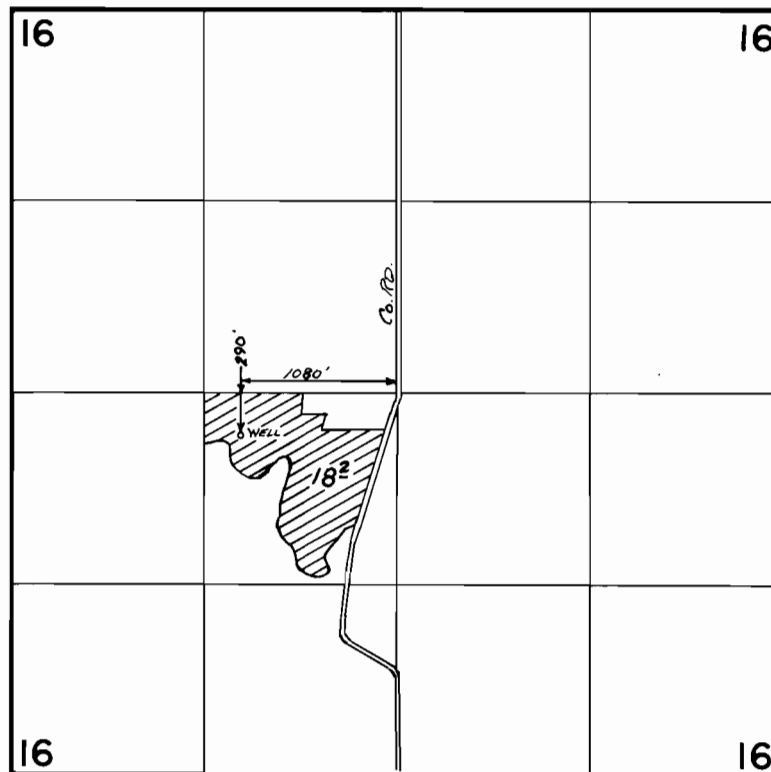

FINAL PROOF SURVEY
UNDER

Application No. G-6894 Permit No. G-6423
IN NAME OF

KEITH RUMGAY

Surveyed Aug. 19 1977, by Bob Barwin