


T7N. R.3W. W.M.

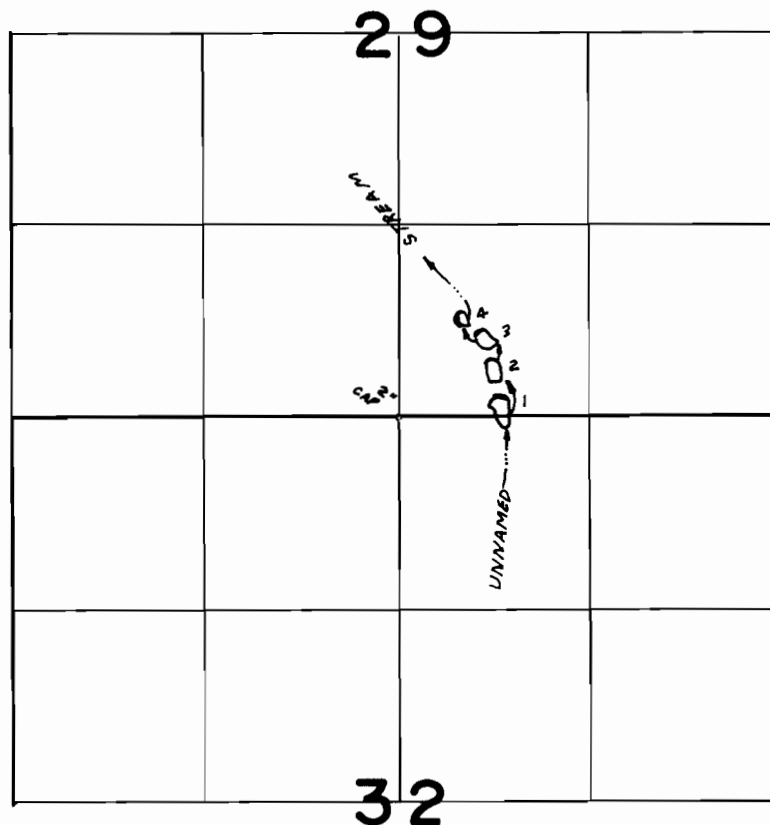

DAM 1- 140' N. & 660' E., DAM 2- 400' N & 620' E., DAM 3- 590' N & 540' E., DAM 4- 680' N. & 400' E., ALL FROM S. 1/4 COR. SEC. 29

FINAL PROOF SURVEY
UNDER

R-46647 R-5574
Application No. 46648 Permit No. 34854
IN NAME OF

HARRY A. & LUCILE H. WHIPPLE

Surveyed JUNE 9, 1976, by L.H. NUNN