T.5N. R.4W. W.M.

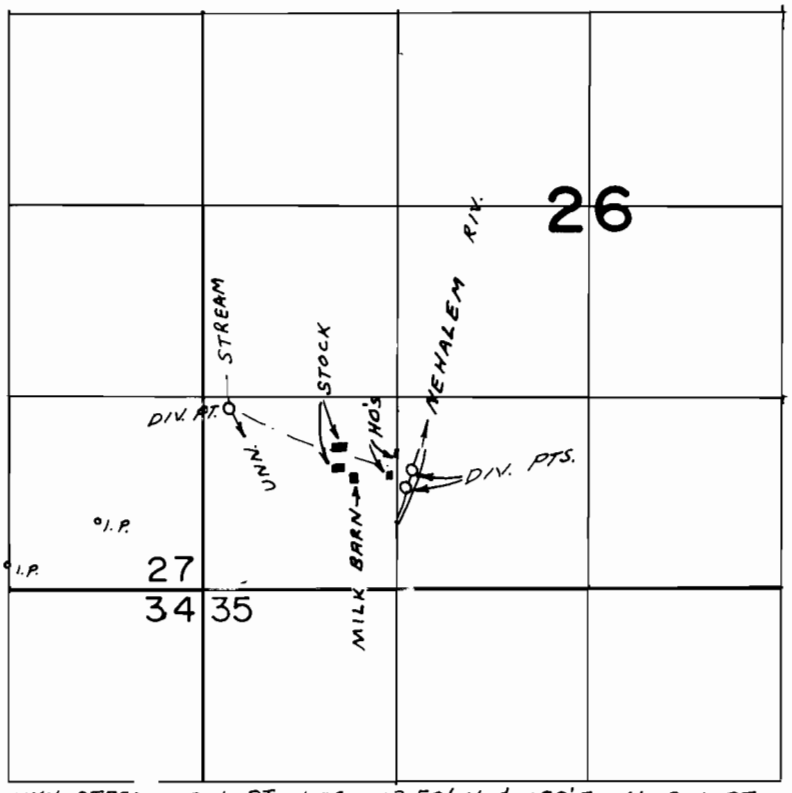

UNN. STREAM DIV. PT LOC. 1250' N. & 180' E., N. DIV. PT. LOC. 820' N. & 1430' E., S. DIV. PT. LOC. 700' N. & 1390' E., ALL FROM THE SW CORNER SECTION 26.

FINAL PROOF SURVEY
UNDER

Application No. 51904 51905 Permit No. 39157 39158

IN NAME OF

LOREN ELLIS JR.

Surveyed MAY 25 1976, by L.H. NUNN

1976-P