


T.40S. R.14W. W.M.

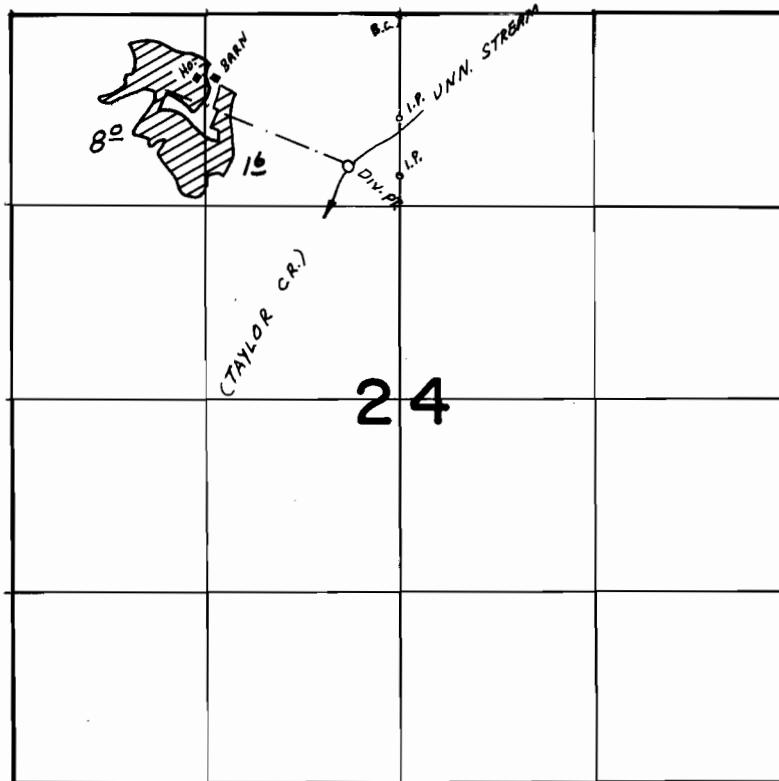

DIV. PT. LOC. 1040'S. & 360'W. FROM N. 1/4 COR. SEC. 24

FINAL PROOF SURVEY
UNDER

Application No. 44556 Permit No. 33349
IN NAME OF

KARL & LOUISE OSTENBERG

Surveyed AUG. 31. 1976., by L.H. NUNN