


T.41S.R.35E.W.M.

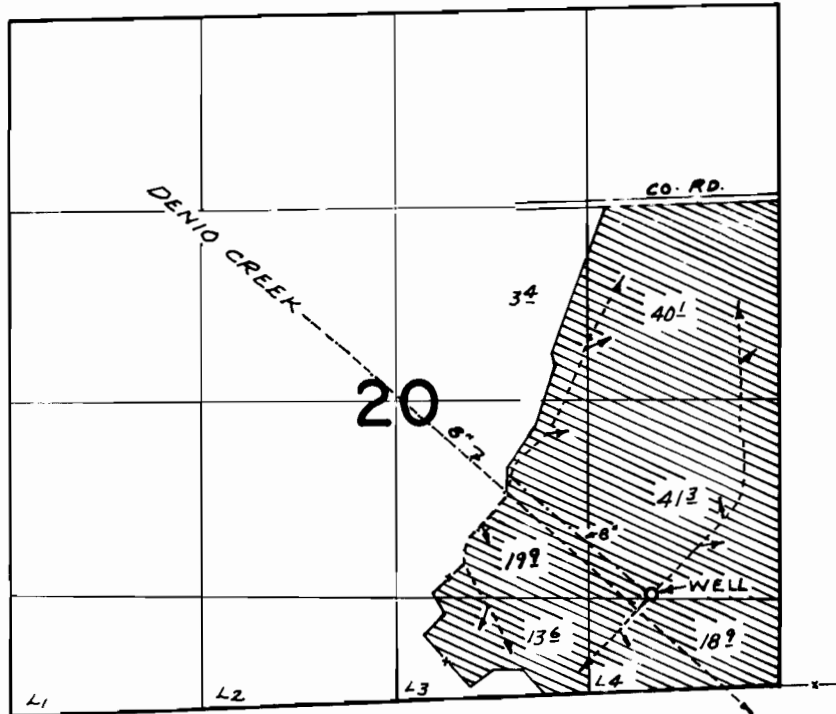

WELL LOC: 630' N. & 880' W. FROM S.E. COR. SEC. 20

FINAL PROOF SURVEY UNDER

Application No. G-3596 Permit No. G-3383
IN NAME OF

WILLIAM P. & RUTH T. MOSER

Surveyed JUNE 19, 1976, by R. MUCKEN