


G-5813  
46776

T.23S.R.31E.W.M.

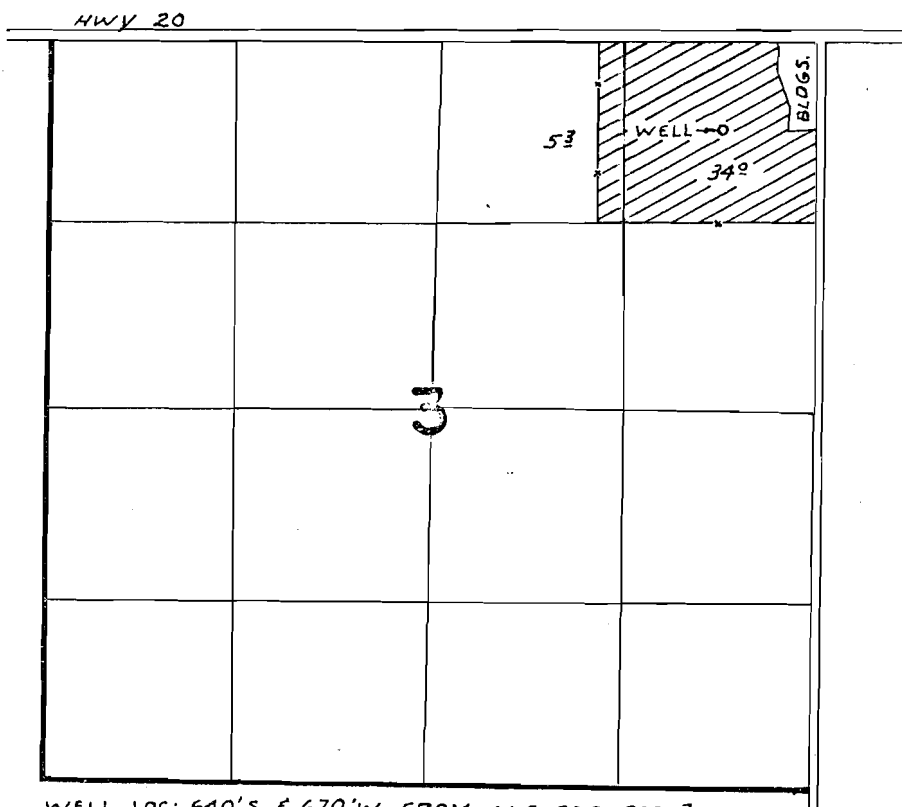

FINAL PROOF SURVEY  
UNDER

Application No. G-6357. Permit No. G-5813.  
IN NAME OF

.....FRANK W. & HAZEL J. GIBSON.....

Surveyed AUG. 11, 1976., by R. MUCKEN