


T.25S.R.35E.W.M.

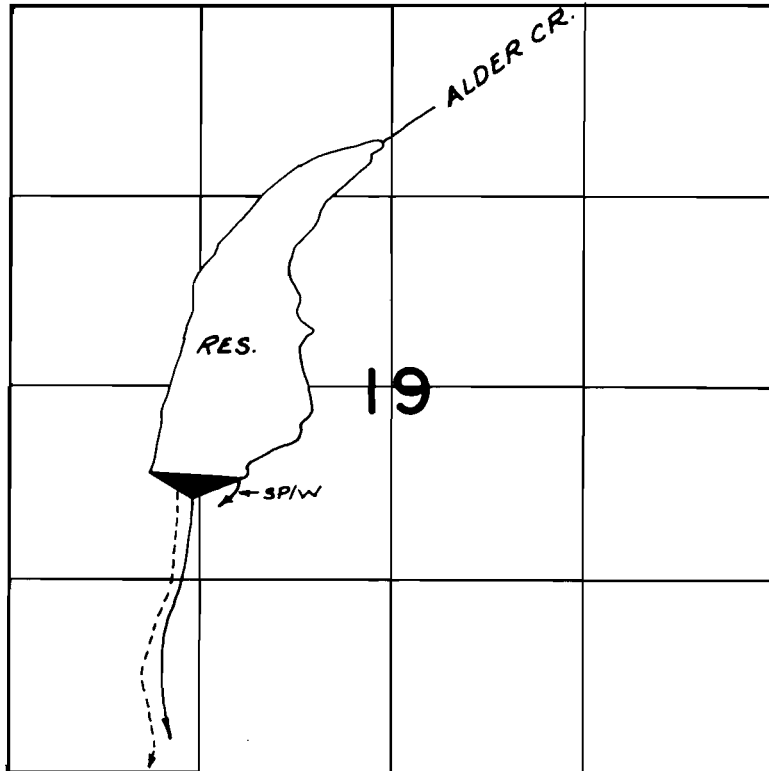

FINAL PROOF SURVEY
UNDER

Application No. *R-42675* Permit No. *R-5044*
IN NAME OF

R. H. EMMERSON

Surveyed *AUG. 18, 1976.*, by *R. MUCKEN*