


T.25S.R.35E.W.M.

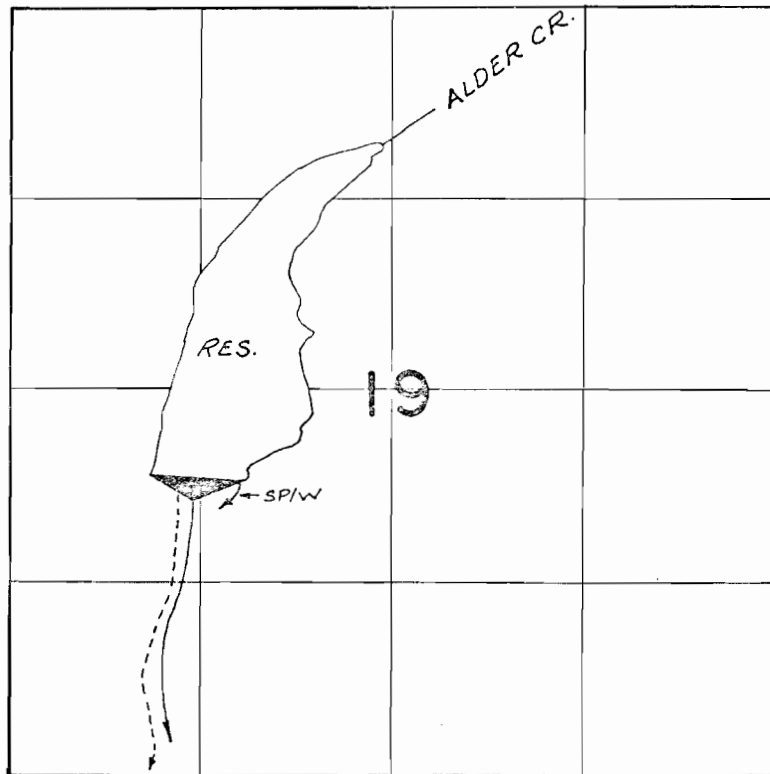

FINAL PROOF SURVEY
UNDER

Application No. R-49675 Permit No. R-5844
IN NAME OF

.....R. H. EMMERSON.....

Surveyed AUG. 18, 1976. by R. MUCKEN