


67-5544

46780

T.28S.R.14E.W.M.

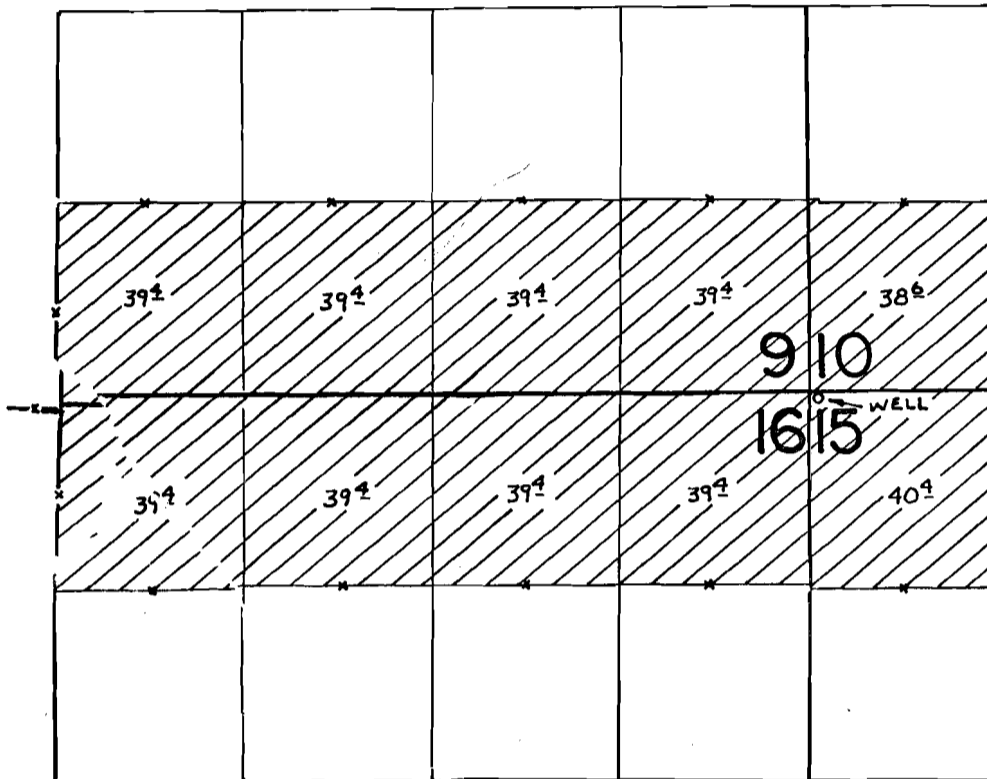

WELL LOC: 50' S. & 60' E. FROM N.W. COR. SEC. 15

FINAL PROOF SURVEY UNDER

Application No. G-5762 Permit No. G-5544
IN NAME OF

.....CAMERON CLIFF.....

Surveyed OCT. 27, 1976, by R. MUCKEN

1976-2-5 & CHZ-1KK-168