


U-445

44781

T.27 S.R.15 E.W.M.

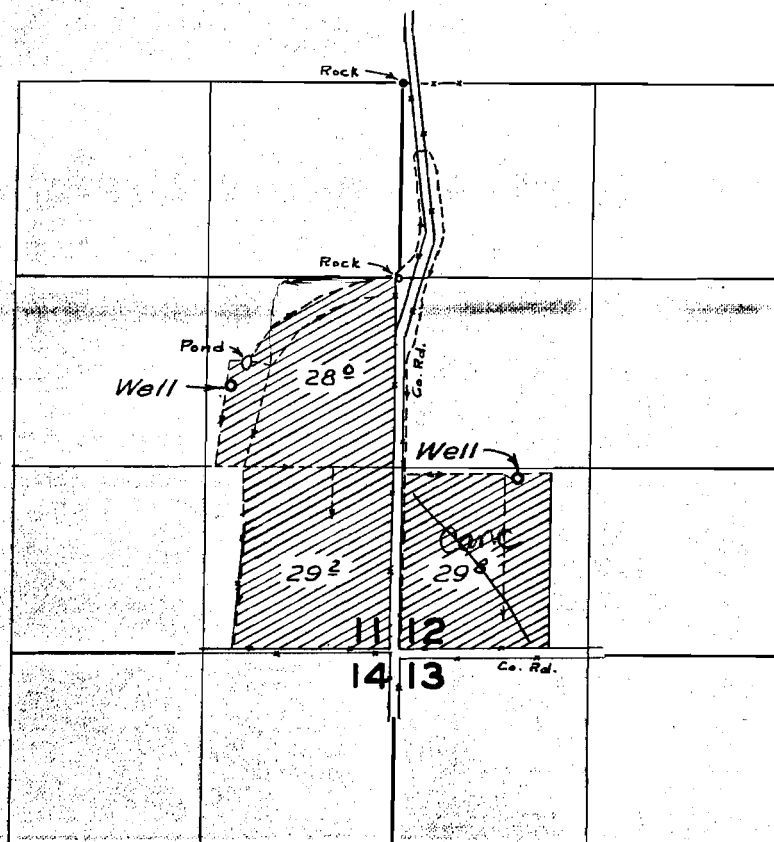

FINAL PROOF SURVEY UNDER

Application No. U-494 Permit No. U-445
IN NAME OF

K.O. BUICK, ANNA L. BUICK & MALCOM K. BUICK Trans TO G. Scott

Surveyed 7 May 1959 by M. B. Rich