


T. 15S., R. 4W., W. M.

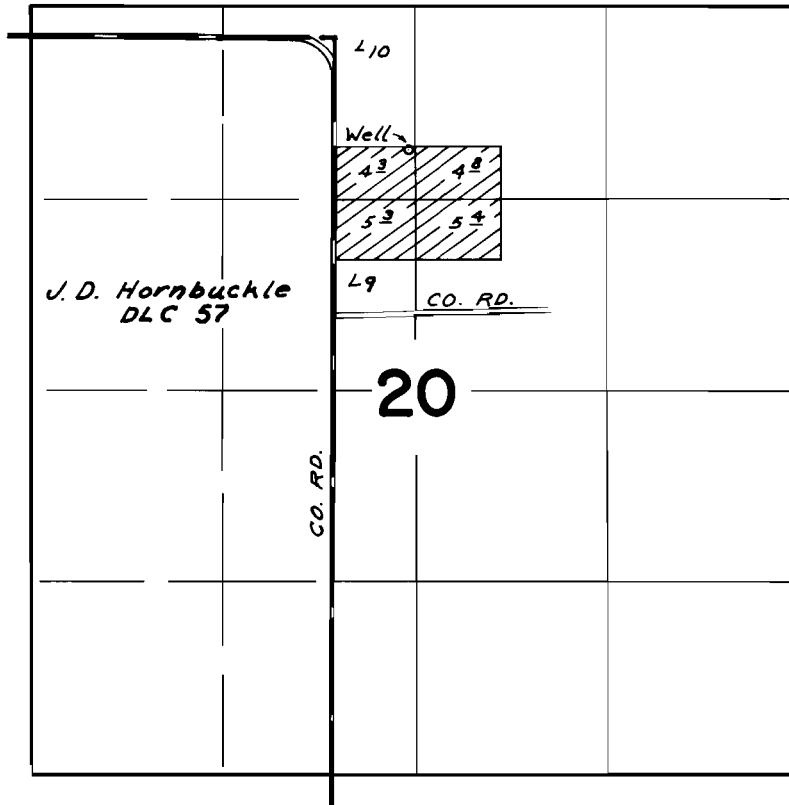

Well Loc: 980'S. of 2680'W. from NE. Cor. Sec. 20

FINAL PROOF SURVEY UNDER

Application No. G-6678 Permit No. G-6230
IN NAME OF

Robert E. Bryson

Surveyed May 11, 1976, by D.M. Norby