


T.15S., R.5 W., W.M.

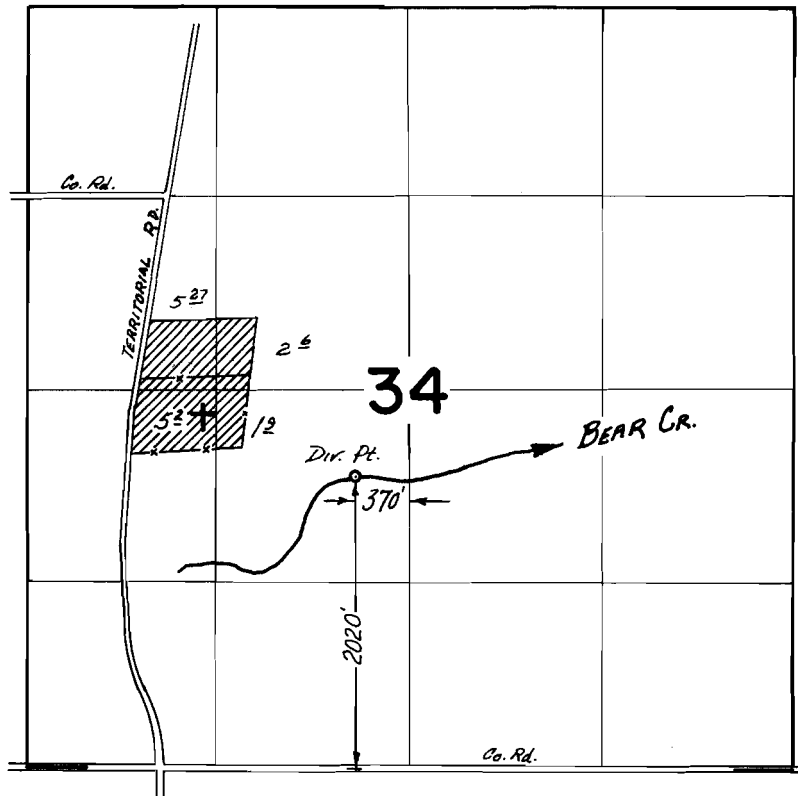

FINAL PROOF SURVEY
UNDER

Application No. 43410 Permit No. 32458
IN NAME OF

OASIS LODGE No. 41 - I.O.O.F. CEMETERY

Surveyed 27 Sept. 19 72, by D. NORBY