


T.18S. R.8W. W.M.

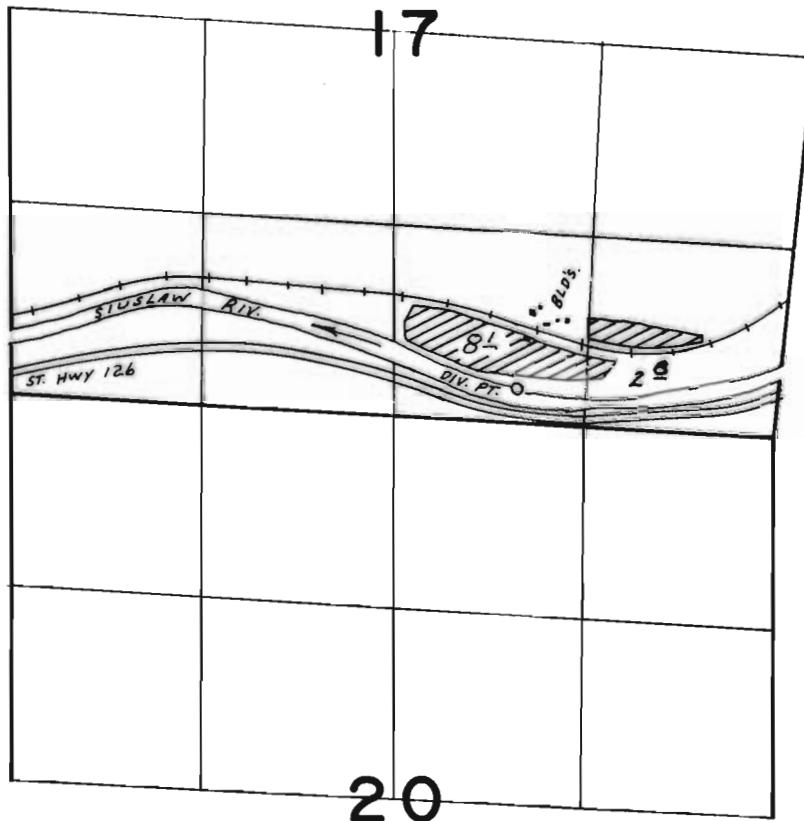

DIV. PT. LOC. 330' N. & 1760 W. FROM SE COR. SEC. 17.

FINAL PROOF SURVEY
UNDER

Application No. 47534... Permit No. 35515...
IN NAME OF

JAMES W. LICHAU

Surveyed MAY 5... 1976, by L.H. NUNN.....