


T.15S. R.5 & 6W. W.M.

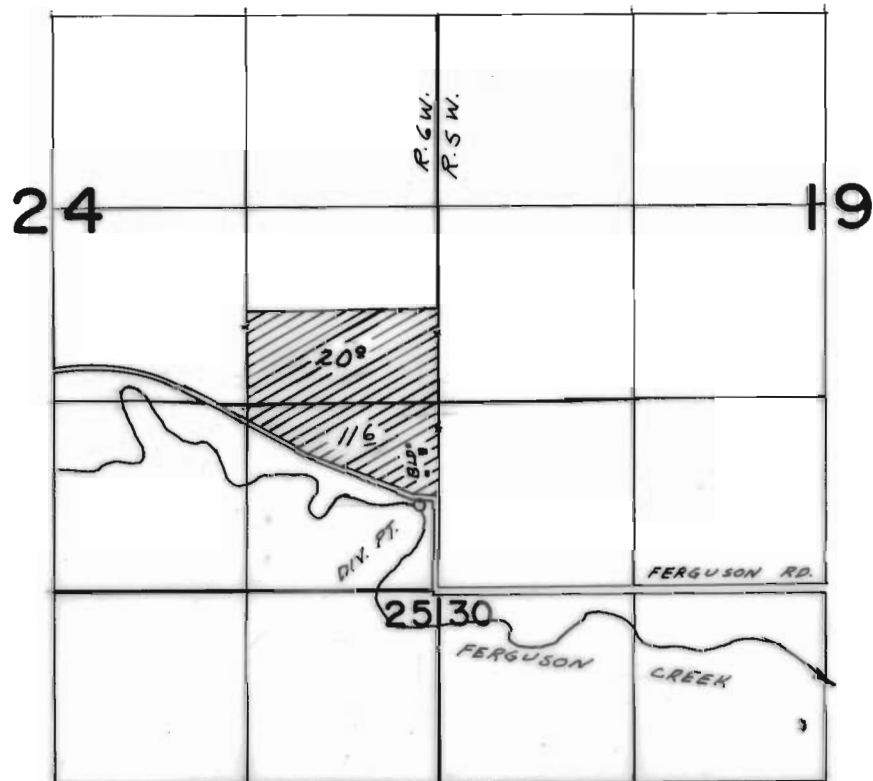

DIV. PT. LOC. 590' N. & 120' W. FROM SE COR. SEC. 24

FINAL PROOF SURVEY
UNDER

Application No. 47800 Permit No. 35224

IN NAME OF
ESTATE OF FRANK E. LEDNICKY
AND BEATRICE T. LEDNICKY

Surveyed MAY 6 1976, by L.H. NUNN