


T.IIS. R.IIW. W.M.

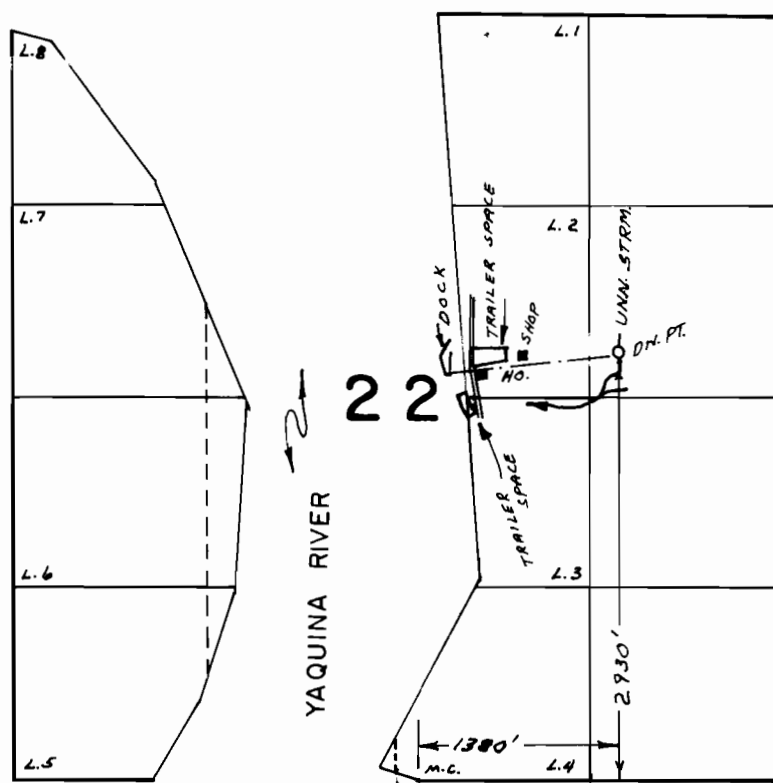

FINAL PROOF SURVEY
UNDER

Application No. 48943... Permit No. 36649...
IN NAME OF

ROY L. & VERA J. SAWYER

Surveyed AUG. 10. 1976, by L.H. NUNN