


T.14S.R.9W.W.M.

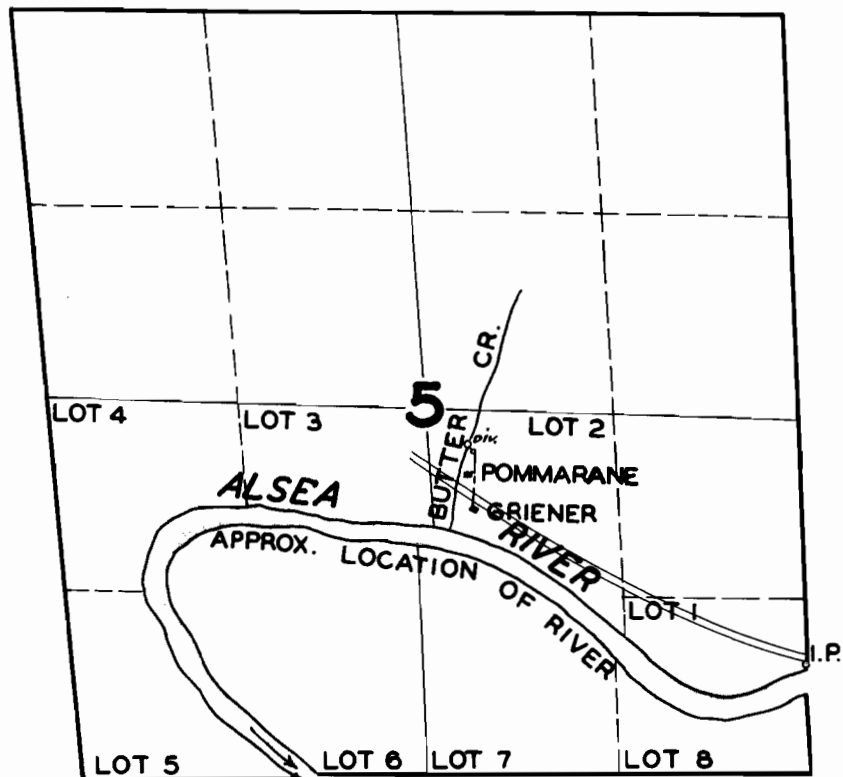

FINAL PROOF SURVEY
UNDER

Application No. 19801 Permit No. 15374
IN NAME OF

TRACY T. PHILLIPS & CARL V. & CLORIS MUNDEN

Surveyed AUG. 4 1948, by JAS. E. BUNNELL