



T.14S., R.5W., W.M.

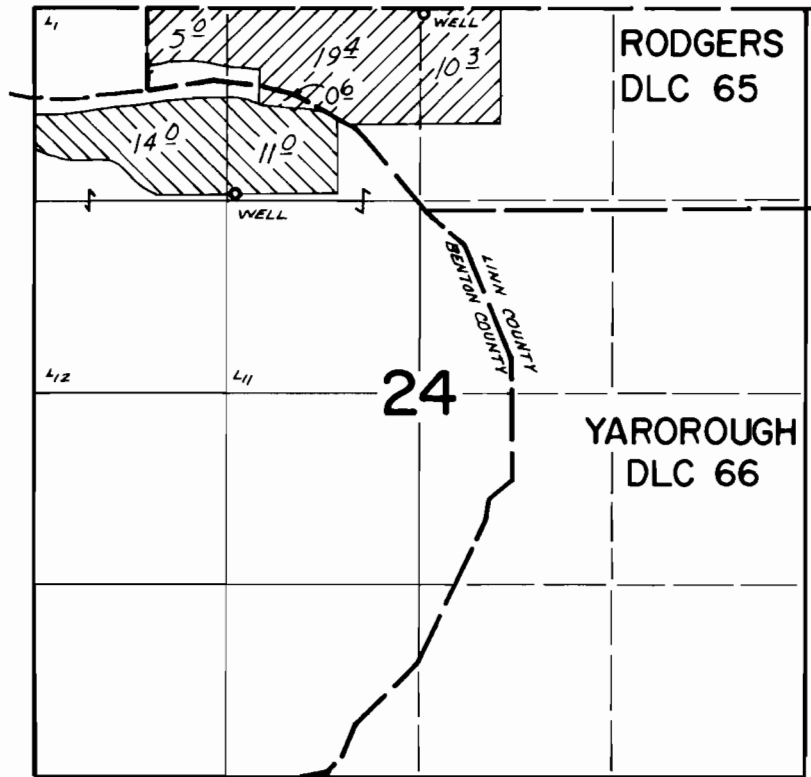

WELLS LOC: NORTH - 30' S & 2660' E; SOUTH - 1280' S & 1380' E BOTH FROM NW COR. SEC. 24

FINAL PROOF SURVEY UNDER

G-5459 G-5371
 Application No. G-6385 Permit No. G-5977
 IN NAME OF

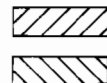

GUY M. GILMORE

Surveyed May 17 1976, by D. Norby