


T.6S.,R.2W.,W.M.

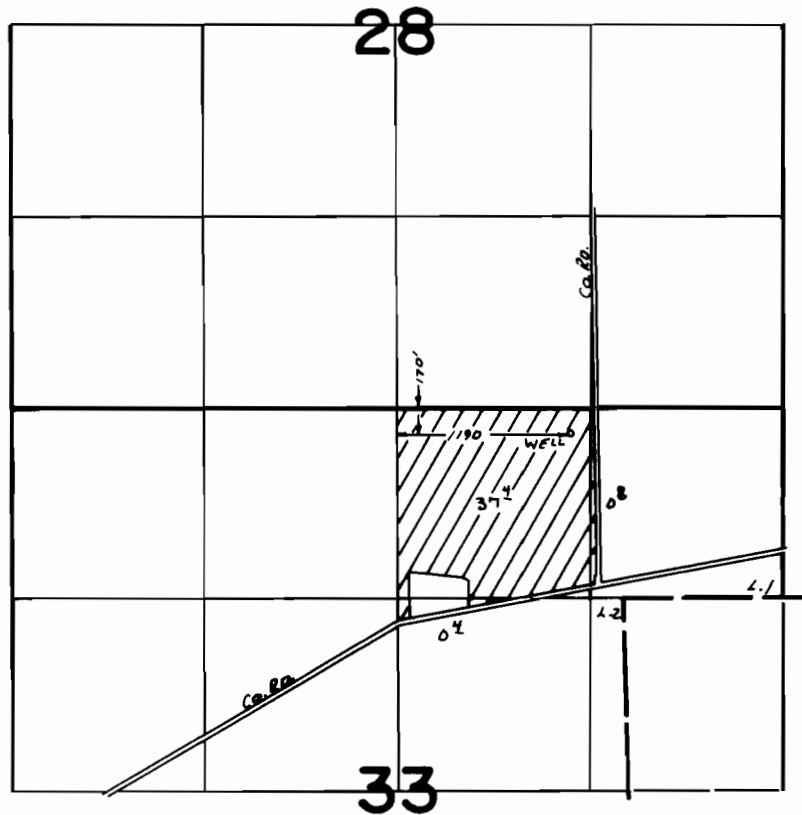

**FINAL PROOF SURVEY**  
UNDER

Application No. G-6179 Permit No. G-5856  
IN NAME OF

VINCENT P. WOODS

Surveyed May 7, 1976, by L. T. G. W.