


T.7S.,R.2W.,W.M.

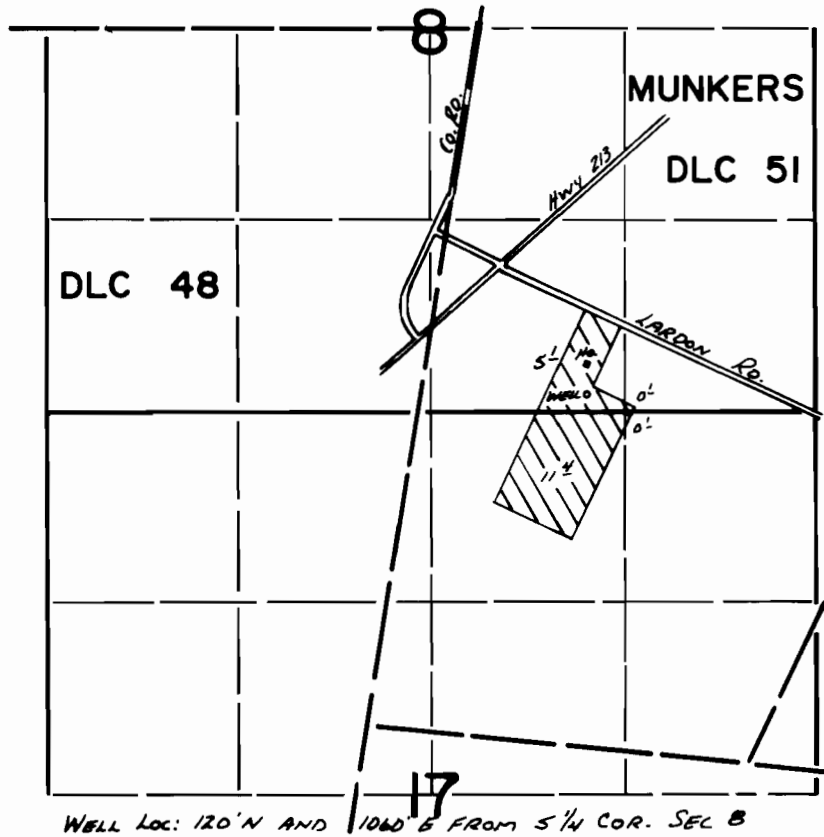

FINAL PROOF SURVEY
UNDER

Application No. G-6220 Permit No. G-5874
IN NAME OF

LEONARD E. KUNZMAN

Surveyed MAY 19 1976, by L. Toll