


T.7S.,R.2W.,W.M.

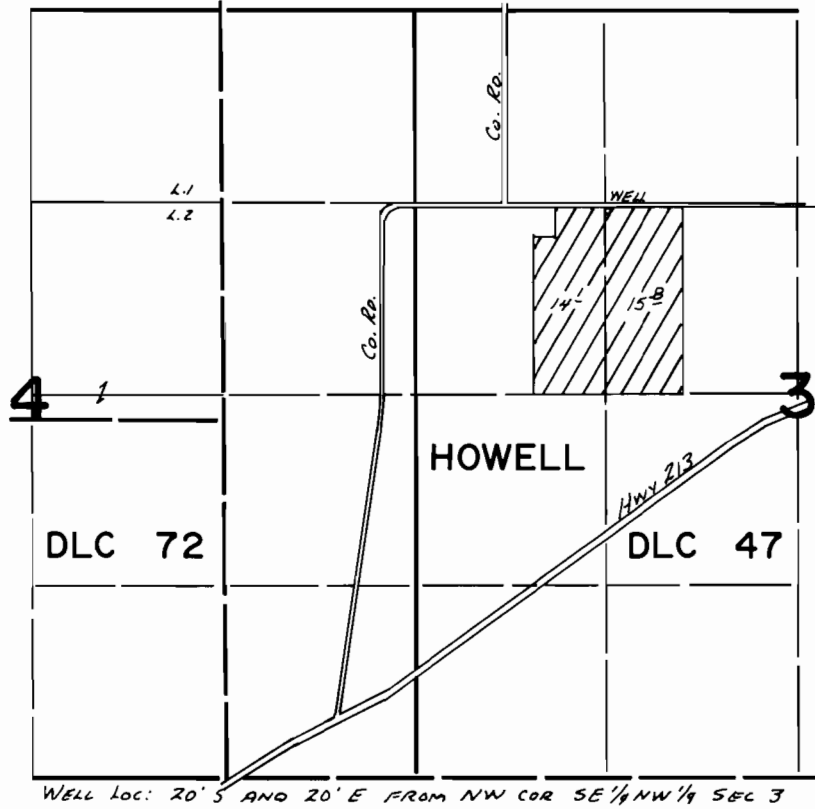

**FINAL PROOF SURVEY**  
UNDER

Application No. G-6746 Permit No. G-6269  
IN NAME OF

ROBERT DITCHEN

Surveyed JUNE 1, 1976, by L. TOLL