


T.7S.,R.18&2W.,W.M.

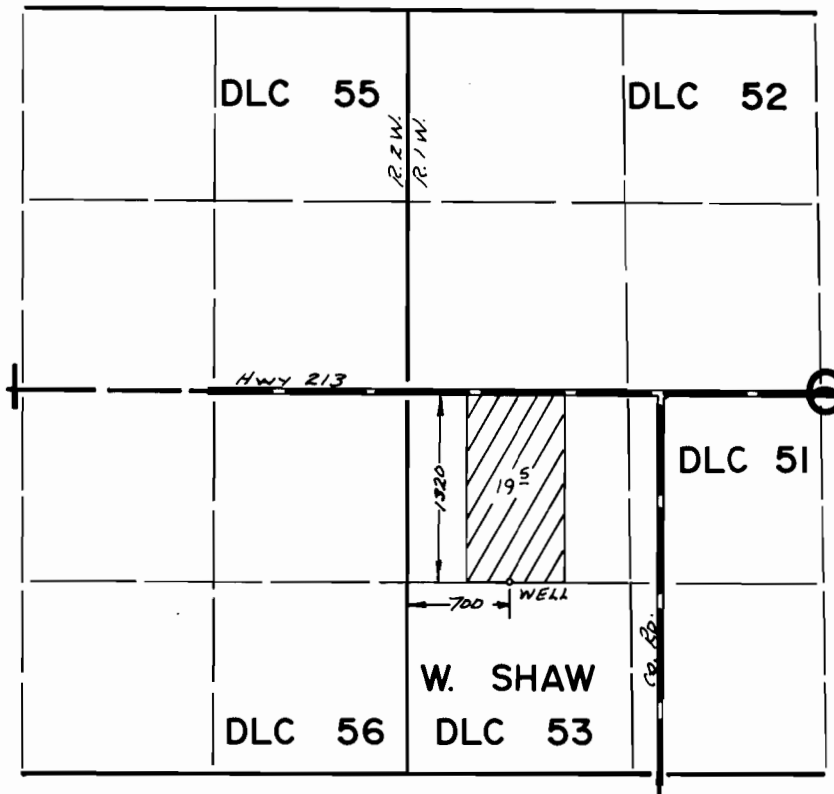

FINAL PROOF SURVEY
UNDER

Application No. G-6798 Permit No. G-6306
IN NAME OF

MELVIN E. KING

Surveyed Aug. 13, 1976, by L. J. P. L.