


T.6S.,R.1E.,W.M.

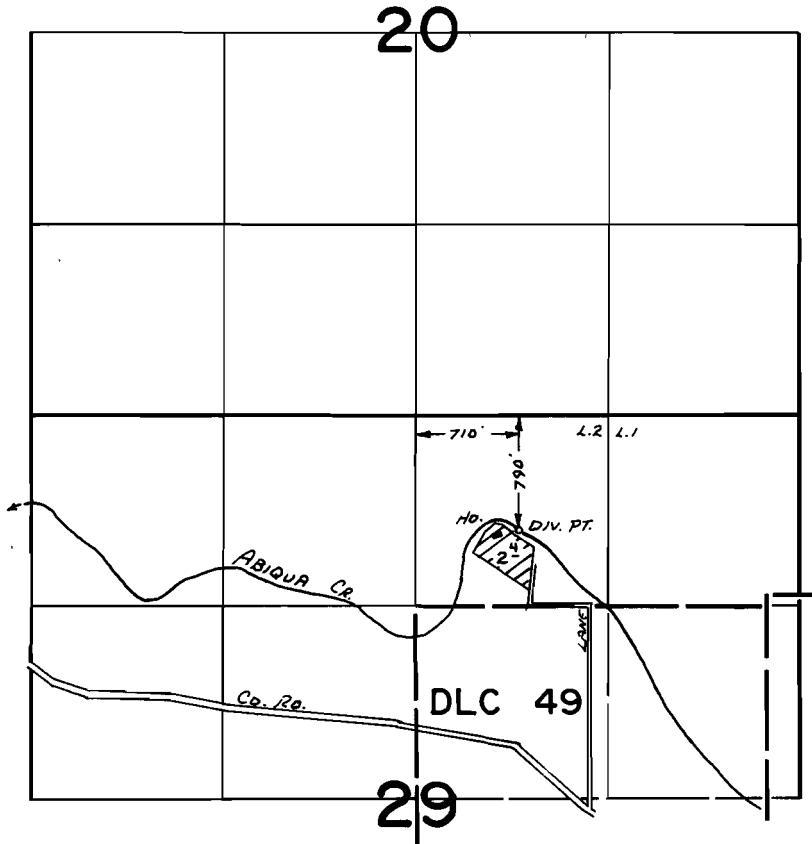

FINAL PROOF SURVEY
UNDER

Application No. 48468 Permit No. 36376
IN NAME OF

WALTER W. HONDERICH

Surveyed Aug. 12 1976, by L. T. Holt