


T.6S.,R.1W.,W.M.

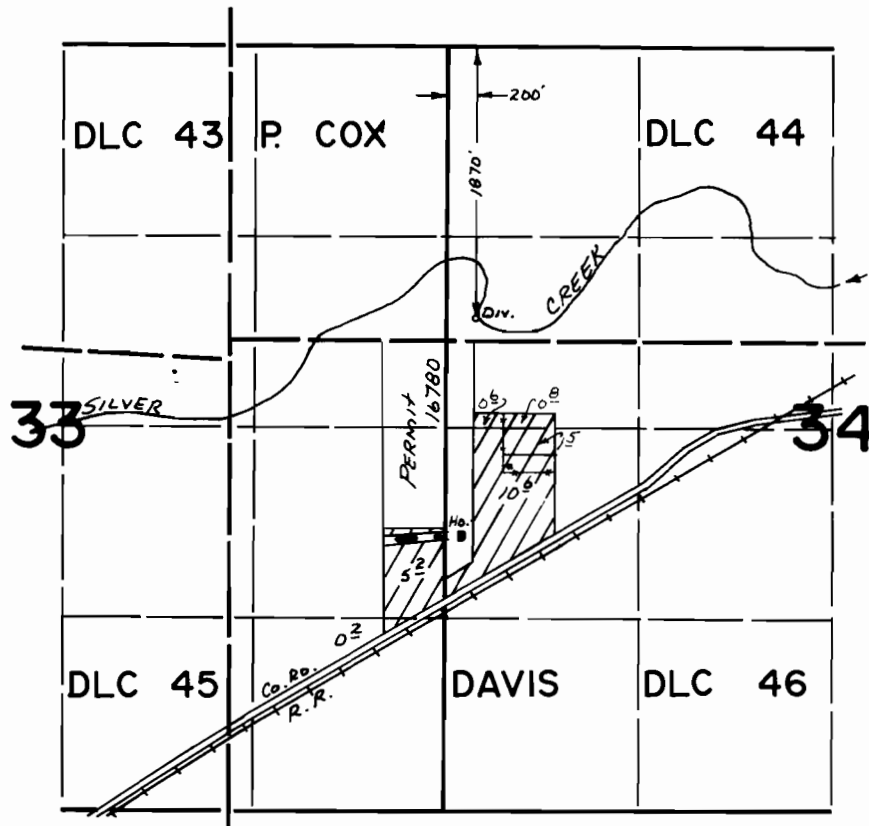

FINAL PROOF SURVEY UNDER

Application No. 51785 Permit No. 39015
IN NAME OF

CARL A. REED

Surveyed Oct. 8, 1976, by L. Toll