


T.1S.,R.5E.,W.M.

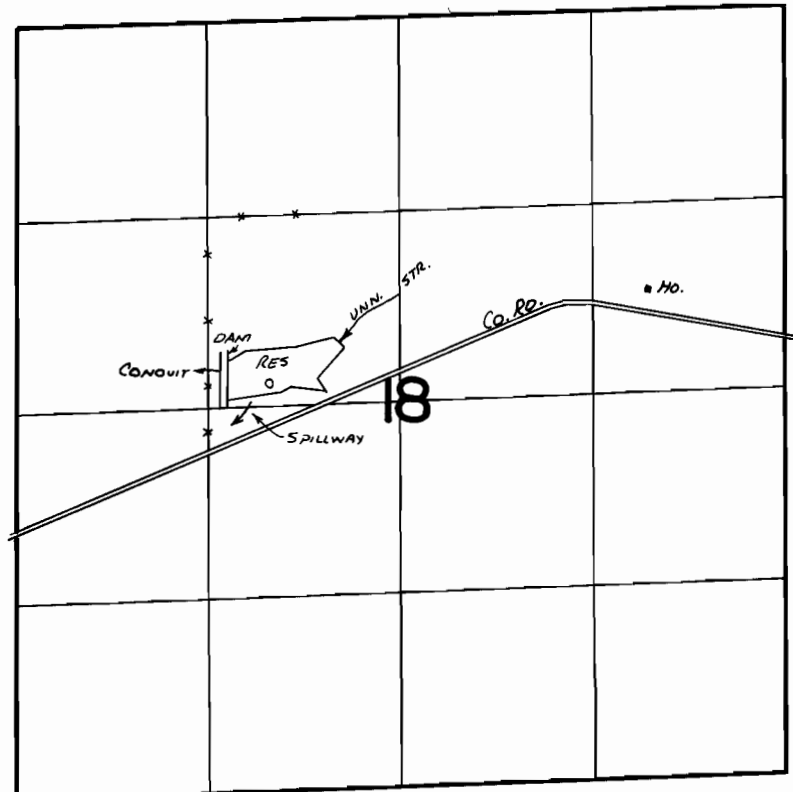

DAM Loc: 1100' S AND 100' E FROM NW COR SE 1/4 NW 1/4 SEC 18

FINAL PROOF SURVEY
UNDER

Application No. R-41610 41611 Permit No. R-4701 31125
IN NAME OF

DONALD G. OR HESTER G. OSBURN

Surveyed JUNE 9 1976, by L. TOLL