


T. IN. R. 2 E. W. M.

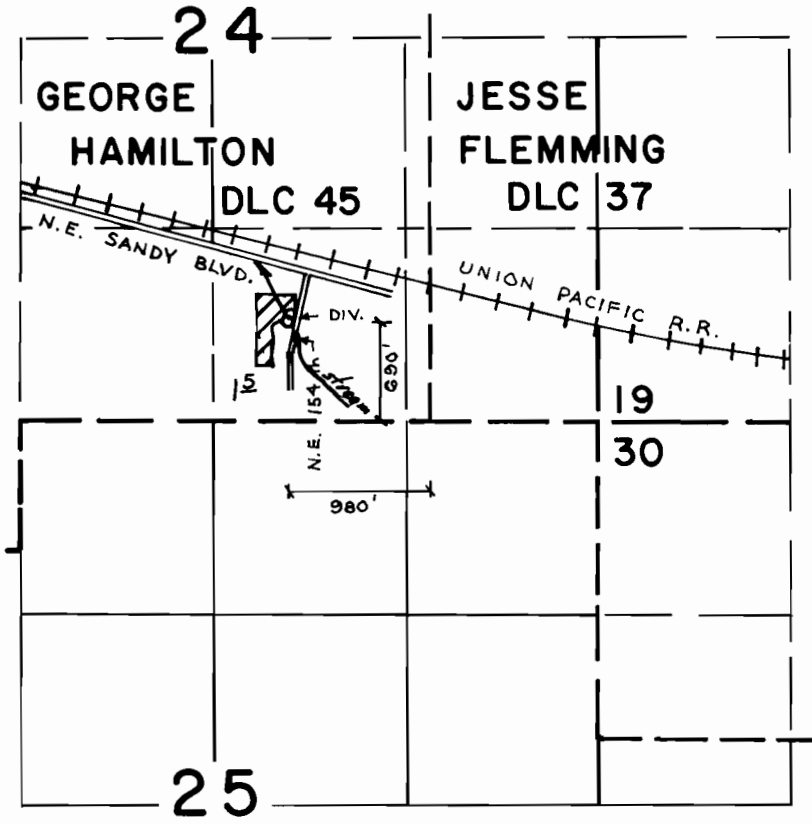

**FINAL PROOF SURVEY**  
UNDER

Application No. 48333 Permit No. 36295  
IN NAME OF

MYRL L. VAN ALSTYNE

Surveyed July 9, 1976, by R. G. Mucken