


T.2N.,R.2W.,W.M.

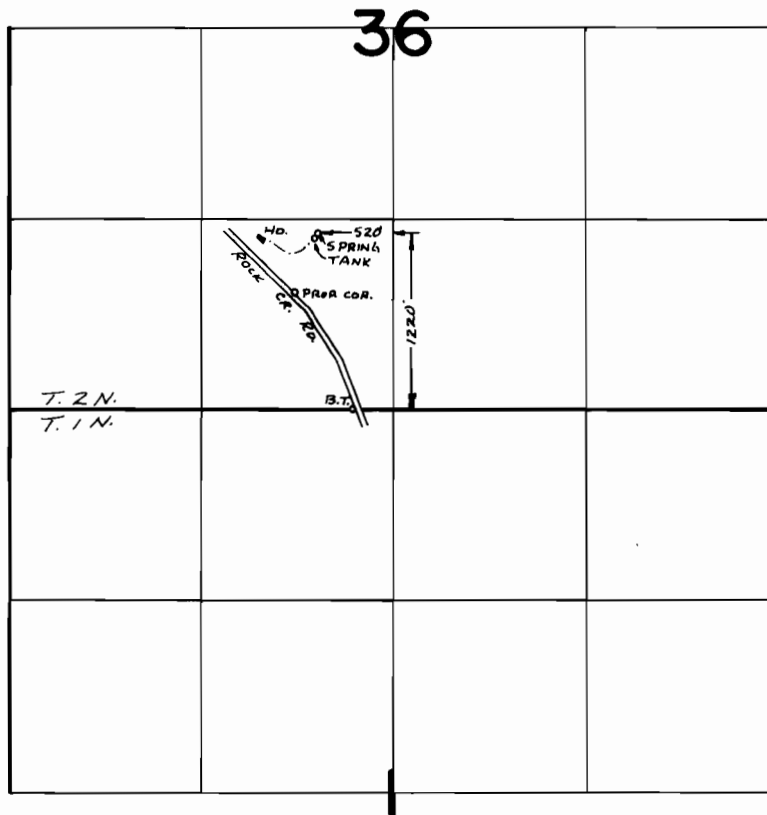

FINAL PROOF SURVEY
UNDER

Application No. 51880 Permit No. 39051
IN NAME OF

HARVEY C. ELMORE

Surveyed JUNE 8, 1976, by L. TOLL