


T. 6S.R. 7W.W.M.

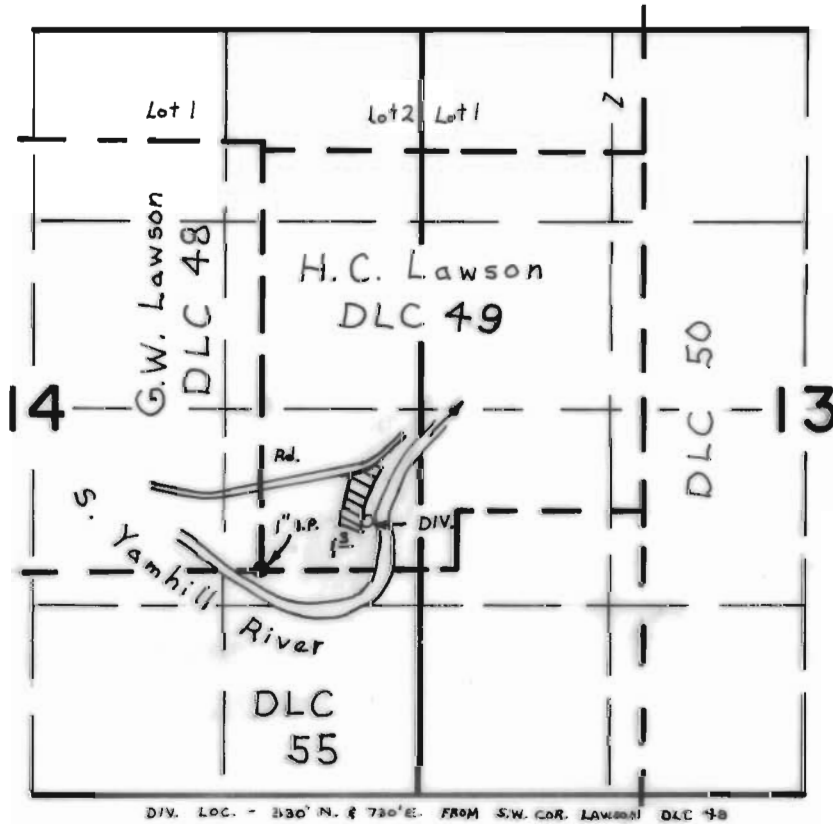

FINAL PROOF SURVEY
UNDER

Application No. 51612 Permit No. 38928
IN NAME OF

D. W. GRIFFITH

Surveyed June 4, 1976, by R. G. Mucken