


# T.8S., R.6W., W.M.

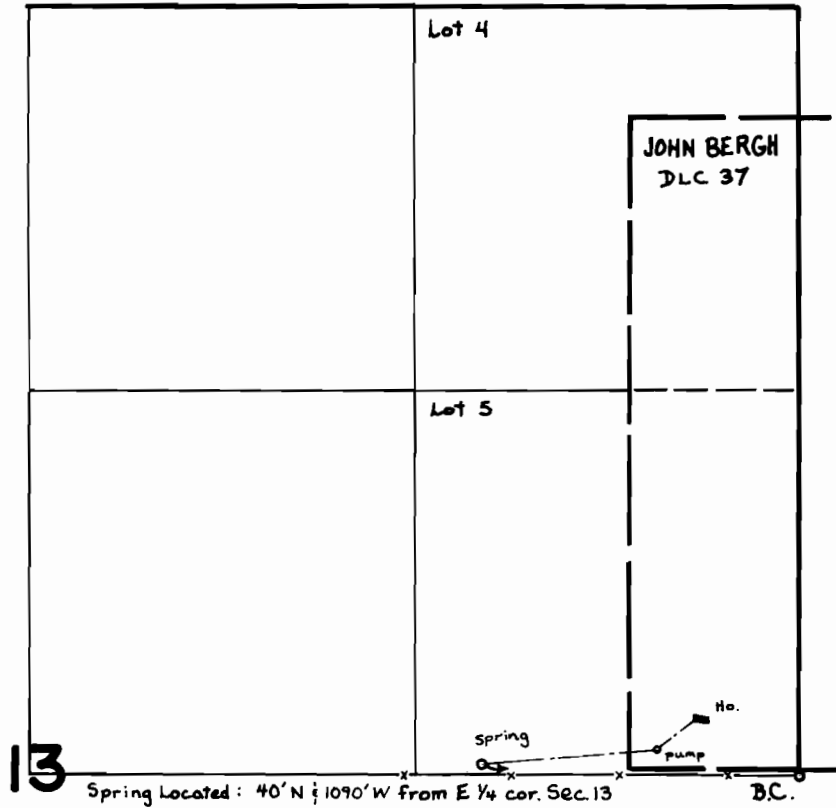

SCALE: 1" = 660'

## FINAL PROOF SURVEY UNDER

Application No. 52400 Permit No. 39417  
IN NAME OF

Red-Tailed Hawk Farm

Surveyed AUG. 12 1976, by C. KING