


T. 4N. R. 37E. W.M.

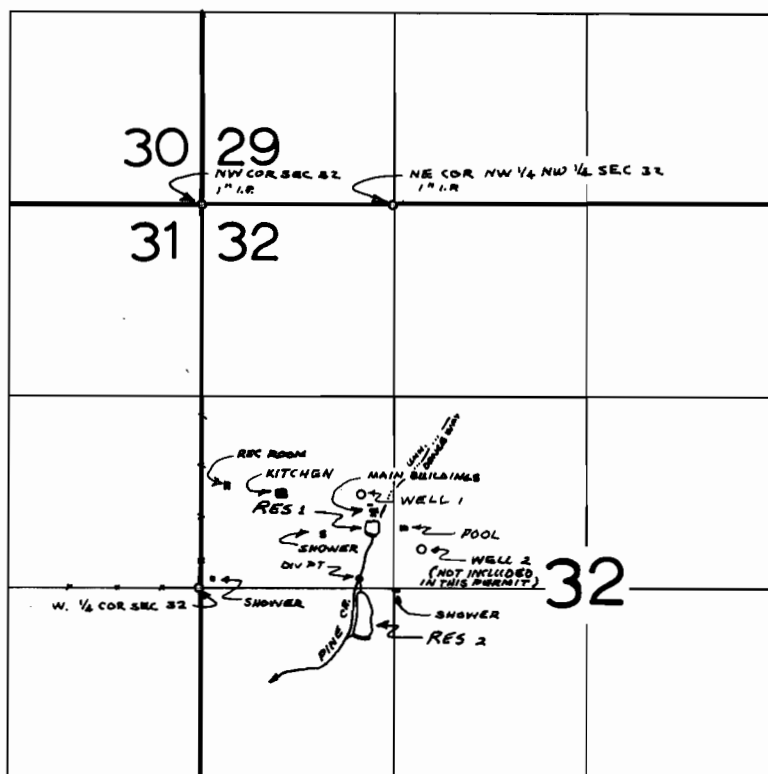

WELL 1 LOCATED 650' N. & 1090' E FROM W 1/4 COR SEC 31
 WELL 2 LOCATED 360' N & 1510' E FROM W 1/4 COR SEC 32
 RES 1 LOCATED 360' N & 1170' E FROM W 1/4 COR SEC 32
 RES 2 LOCATED 340' S & 1030' E FROM W 1/4 COR SEC 32

FINAL PROOF SURVEY UNDER

R47667
47857

R5743
35684

Application No. G 5425 Permit No. G 4930
IN NAME OF

OREGON INSTITUTE FOR REHABILITATION

Surveyed OCT 17 1977, by R. BARWIN