


G 7358
46819

T4N R28E WM.

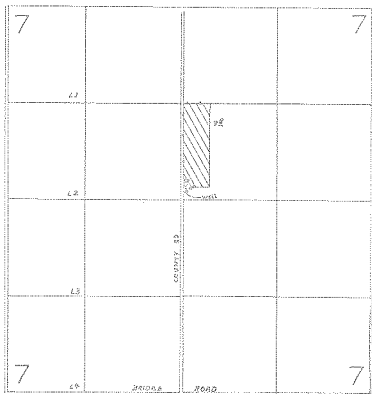

WELL LOCATED 30'E & 200'N CENTER SECTION 7

ANGELLE
SO. V. 37 P. 356

TRANSFERED
T-5228

FINAL PROOF SURVEY UNDER

Application No. G-5805 Permit No. G-7358
IN NAME OF

LON G. WADEKAMPER

Surveyed MAR 28 1978, by R.E. BARWIN