


G 6359
42821

T.1S., R.32E., W.M.

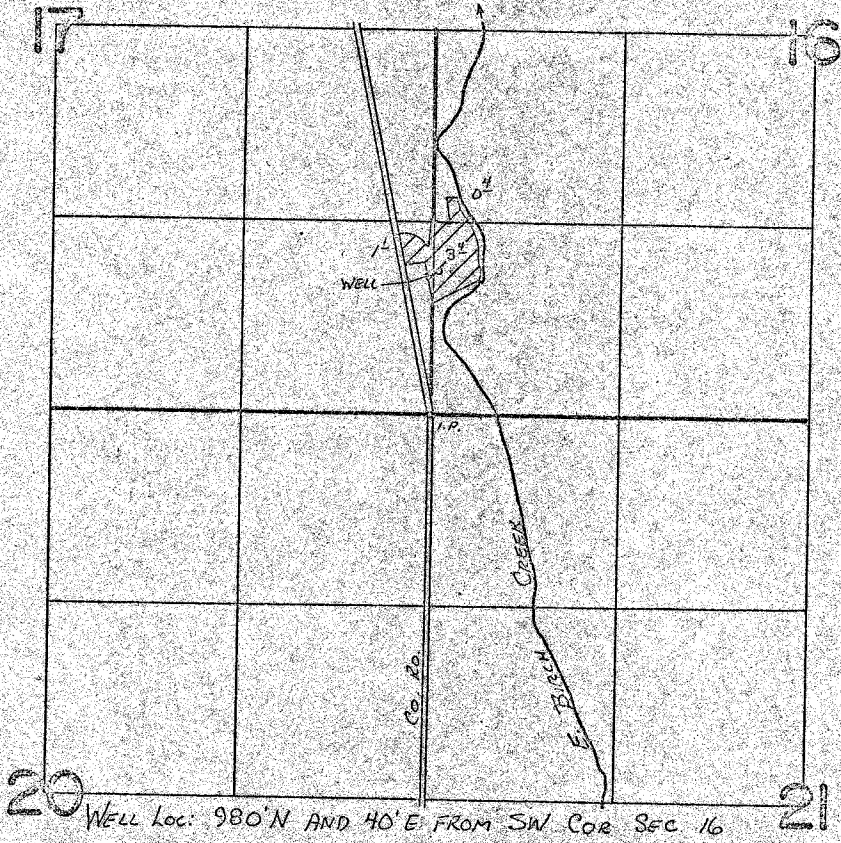

FINAL PROOF SURVEY UNDER

Application No. G-6430 Permit No. G-6359
IN NAME OF

GORDON L. BYRNES

Surveyed APRIL 13, 1976, by L. TOLL