


G-6205  
46822

# T.3N.R.33E.W.M.

Application No. G6636  
Permit No. G 6205

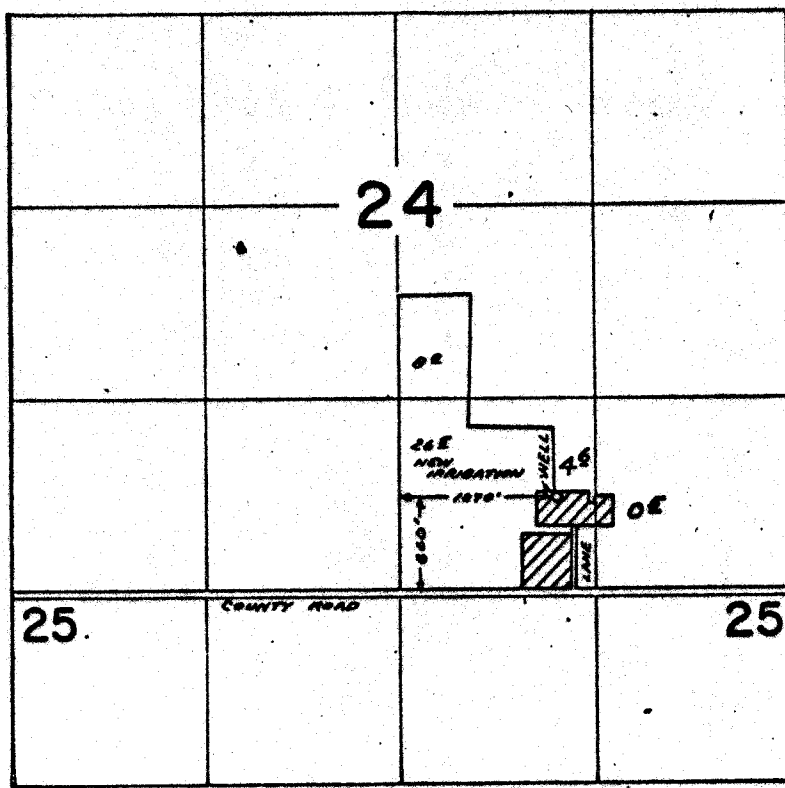

## FINAL PROOF SURVEY UNDER

Application No. G-1037 Permit No. G-1147  
IN NAME OF  
PENDLETON BRANCH EXPERIMENT STA.  
OREGON STATE UNIVERSITY

Surveyed APR. 18 1973, by D.M. NERRY