G 6271
46923

T. 4N. R. 34E. W.M.

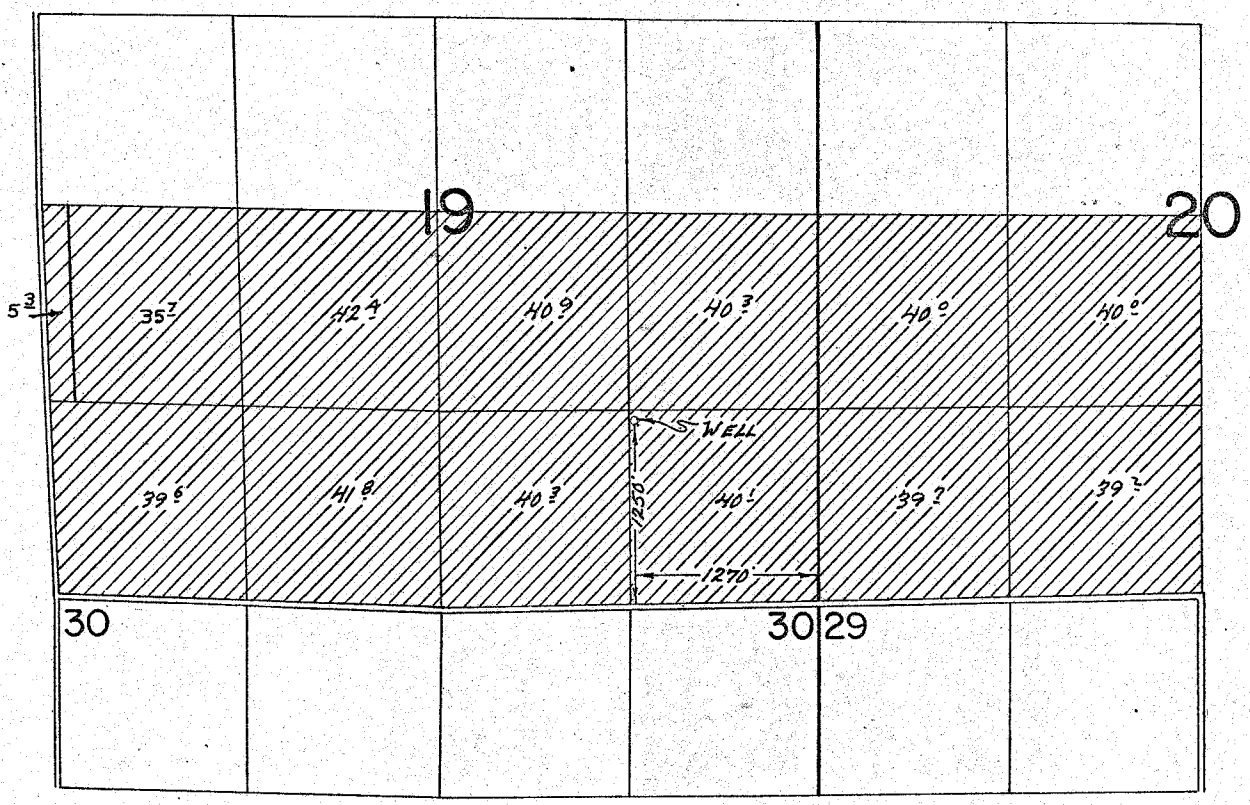

FINAL PROOF SURVEY

UNDER

Application No. G-6748 G-3232 Permit No. G-6271 G-3038

IN NAME OF

WILLIAM R. JOHNS, MIRIAM W. JOHNS, MAURICE R. & DONNA JOHNS, JAMES R. & HELEN SMITH & LAWRENCE BEAMER

Surveyed APRIL 17, 1973, APRIL 12, 1976 by R.G. MUCKEN L. TOLL

NZ-1MM-195 TP