


T.2N.,R.33E.,W.M.

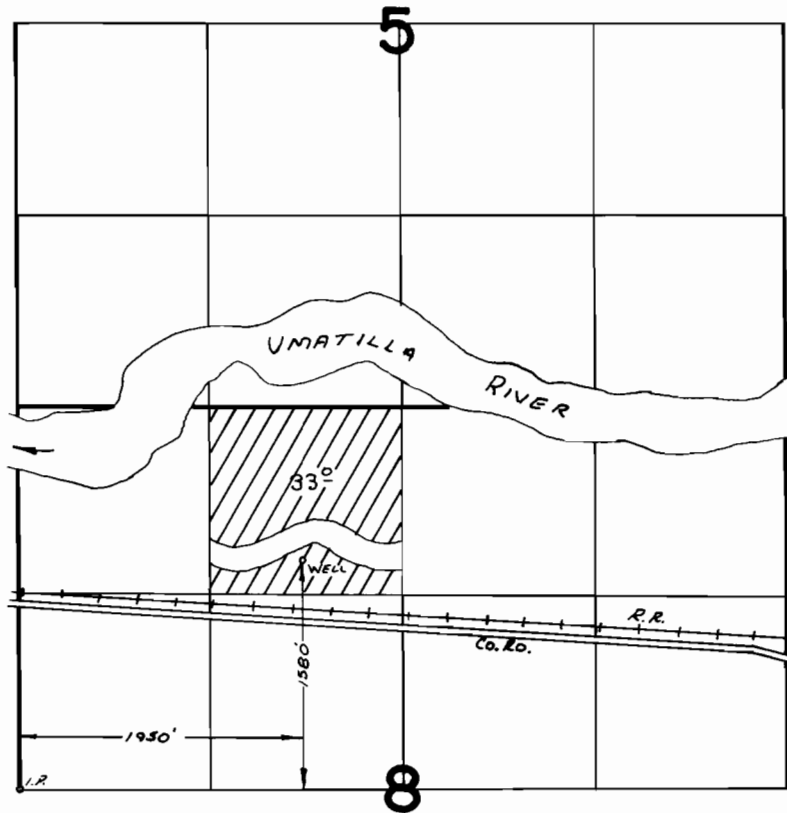

FINAL PROOF SURVEY
UNDER

Application No. G-6902. Permit No. G-6074.
IN NAME OF

.....WILLIAM R. DUFF.....

Surveyed APRIL 12, 1976, by L. TALL.....