


T. 4N. R. 37E. W.M.

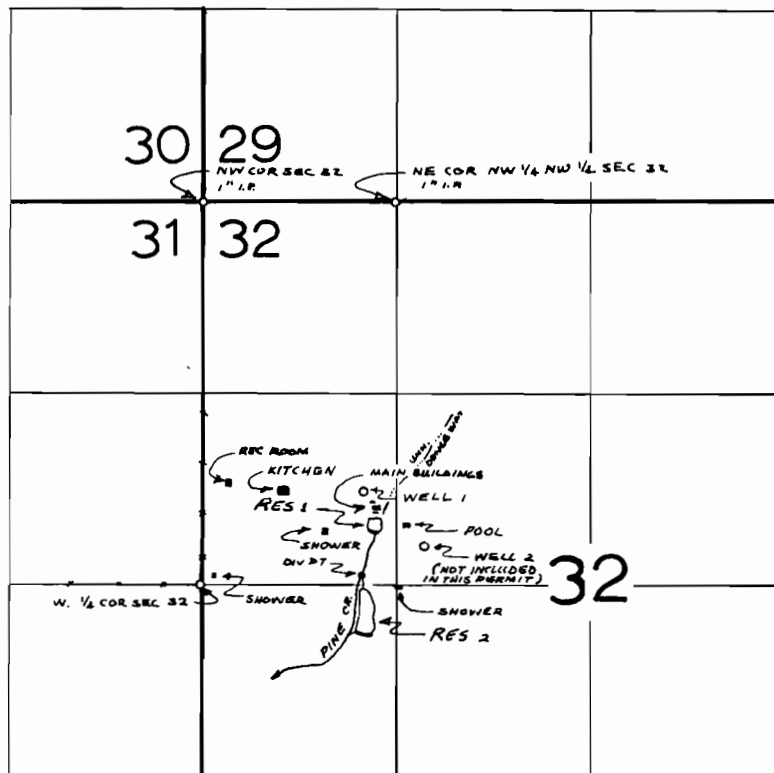

WELL 1 LOCATED 450' N. & 1090' E FROM W 1/4 COR SEC 32  
 WELL 2 LOCATED 360' N & 1510' E FROM W 1/4 COR SEC 32  
 RES 1 LOCATED 360' N & 1170' E FROM W 1/4 COR SEC 32  
 RES 2 LOCATED 360' S & 1030' E FROM W 1/4 COR SEC 32

## FINAL PROOF SURVEY UNDER

R47667 R5743  
 47857 35684  
 Application No. G 5425... Permit No. G 4930...  
 IN NAME OF

OREGON INSTITUTE FOR REHABILITATION...

Surveyed OCT. 17, 1977, by R. BARWIN.....