


T. 4N. R. 37E. W.M.

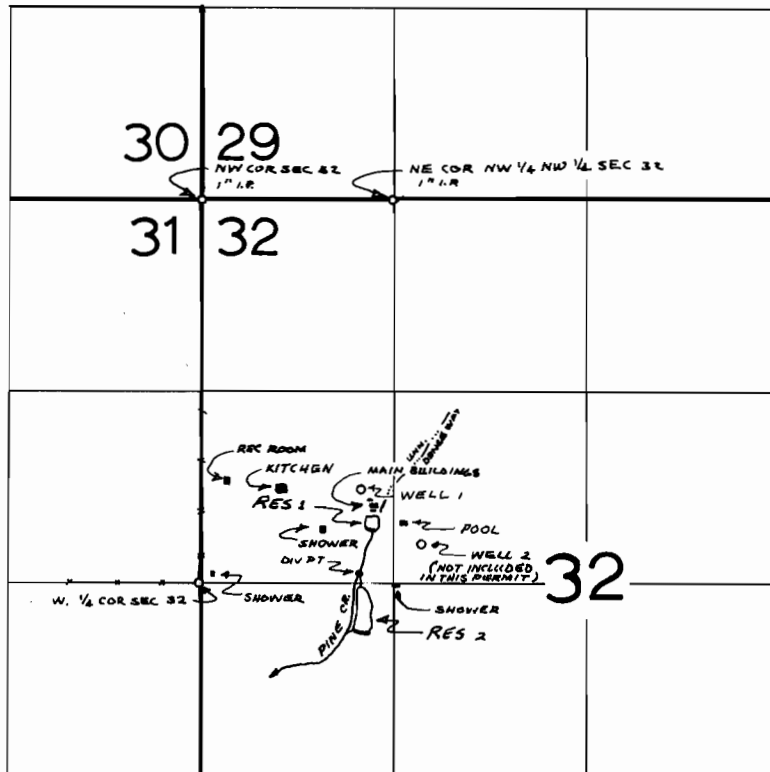

WELL 1 LOCATED 450' N. & 1090' E FROM W 1/4 COR SEC 32
 WELL 2 LOCATED 260' N & 1510' E FROM W 1/4 COR SEC 32
 RES 1 LOCATED 340' N & 1170' E FROM W 1/4 COR SEC 32
 RES 2 LOCATED 340' S & 1030' E FROM W 1/4 COR SEC 32

FINAL PROOF SURVEY UNDER

R47667

R5743

47857

35684

Application No. G. 5425 Permit No. G. 4930
 IN NAME OF

OREGON INSTITUTE FOR REHABILITATION

Surveyed OCT. 17, 1977, by R. BARWIN