


16834

T. 4 S. R. 13 E. W. M.

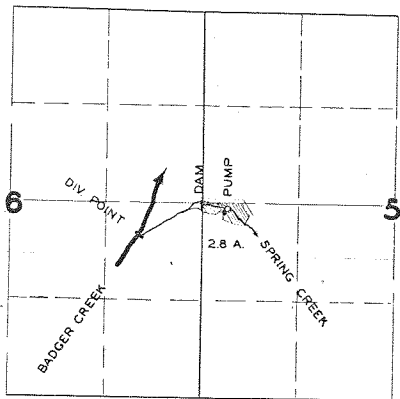

FINAL PROOF SURVEY UNDER

Application No. 21459. Permit No. 16834.
IN NAME OF

E. C. BAILEY

Surveyed JULY 13 1950, by H.L. COFFMAN.