


P-34650  
42844

# T.6S., R.19E., W.M.

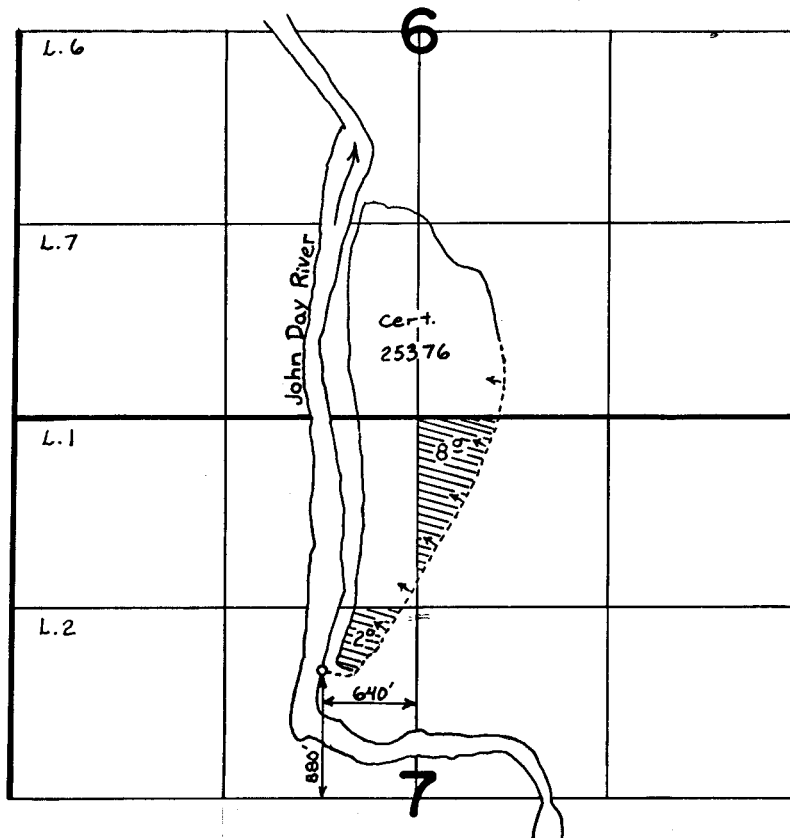

## FINAL PROOF SURVEY UNDER

Application No. 46398 Permit No. 34650  
IN NAME OF

RAY J. BECK

Surveyed AUG. 24, 1976, by D. NORBY