


T.5S., R.6W., W.M.

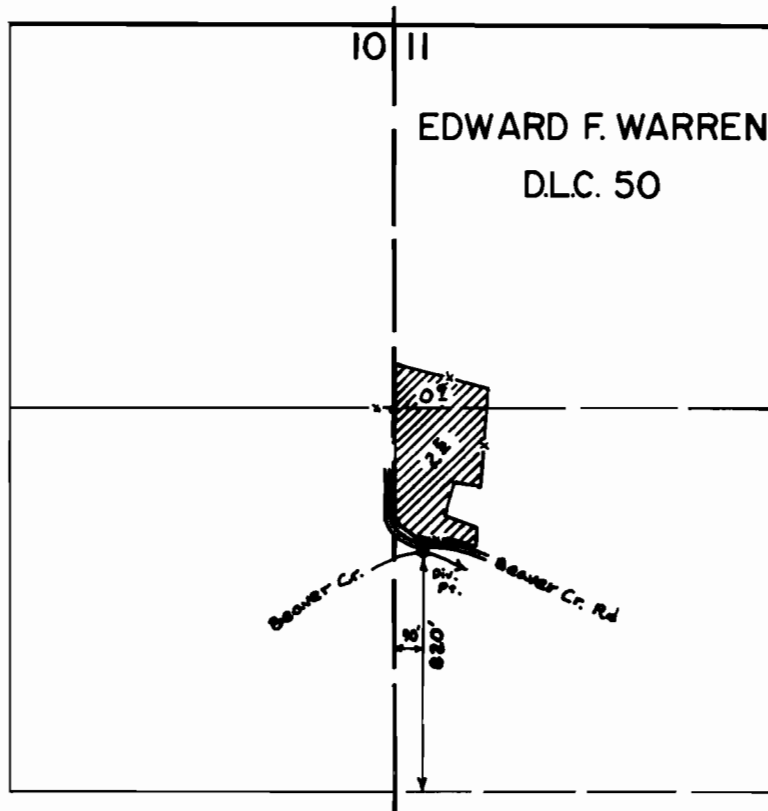

SCALE: 1" = 660'

FINAL PROOF SURVEY
UNDER

Application No. 52605 Permit No. 38564
IN NAME OF

CARLTON SMITH

Surveyed AUG. 3 1976, by D. NORBY