


T. 5 S., R. 6 W., W.M.

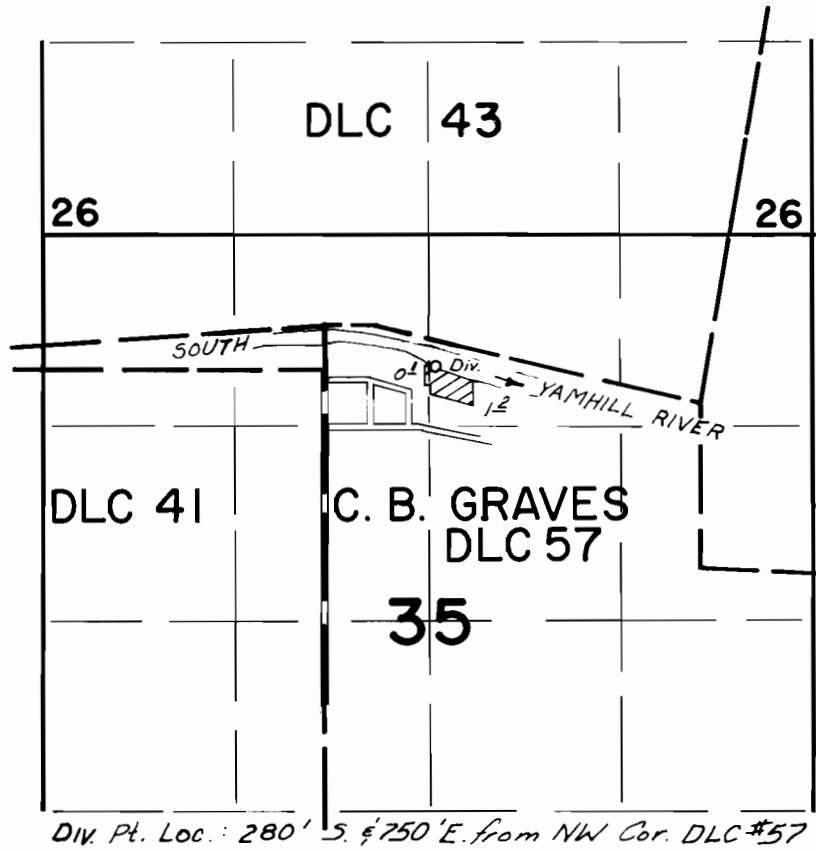

FINAL PROOF SURVEY UNDER

Application No. 52971 Permit No. 39988
IN NAME OF

JAMES F. & NEVA E. ROSE

Surveyed AUG 4, 1976, by D. NORBY