


T. 5 S., R. 6 W., W.M.

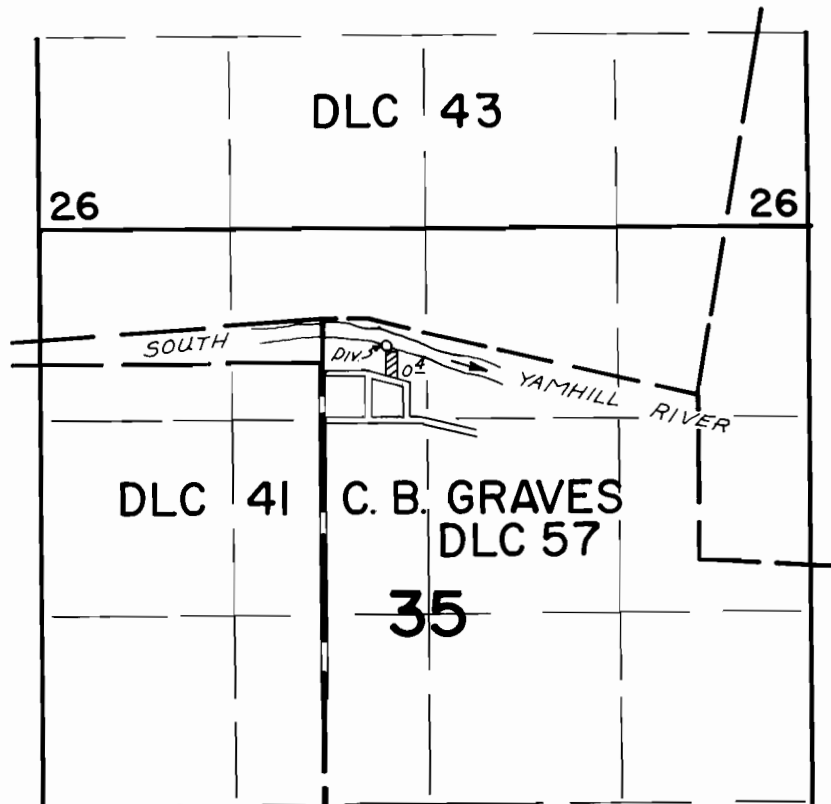

Div. Pt. Loc.: 180 H.S. & 430 H.E., from NW Cor. DLC 57

FINAL PROOF SURVEY
UNDER

Application No. 52974 Permit No. 39991
IN NAME OF

L. DeARMOND & PHYLLIS M. BOCKES

Surveyed AUG 4, 1976, by D. NORBY