


# T.5S.,R.6W.,W.M.

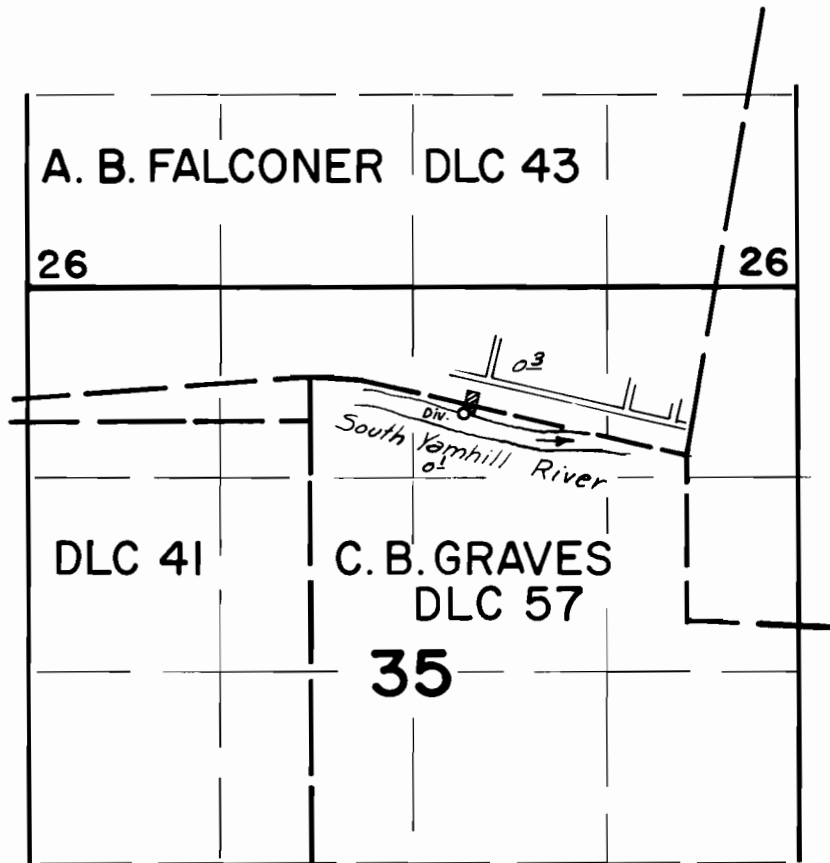

Div. Pt. Loc.: 250' S. & 1050' E. from NW. Cor. DLC. 57

## FINAL PROOF SURVEY UNDER

Application No. 52995. Permit No. 40002  
IN NAME OF

L. DEAN & JEAN HERRON

Surveyed AUG 4, 1976, by D. NORBY