


T. 5 S., R. 6 W., W.M.

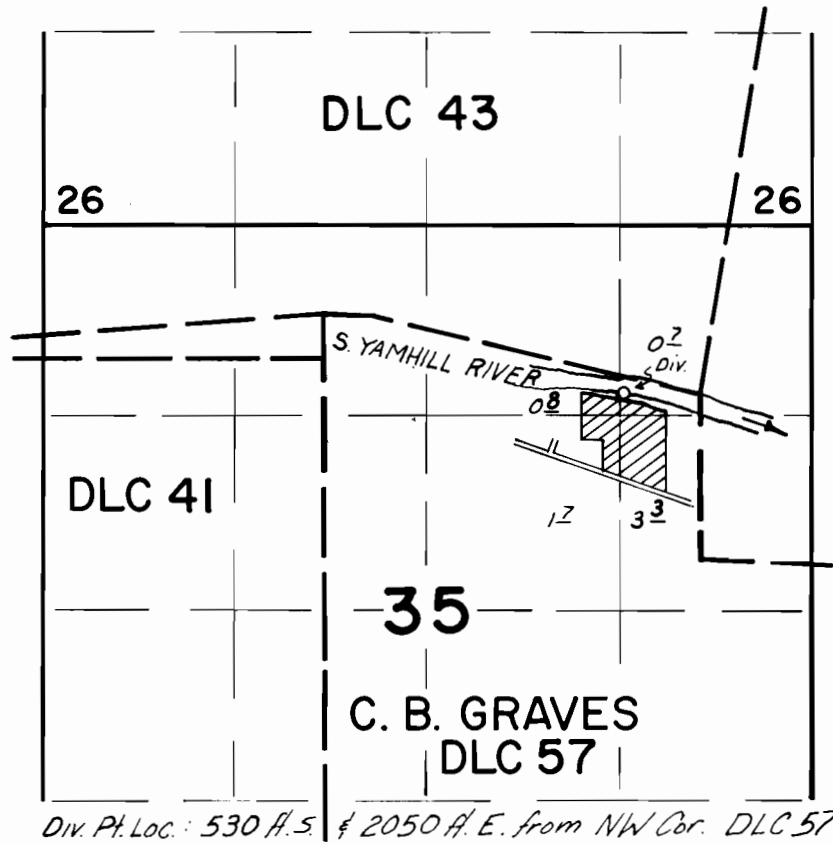

FINAL PROOF SURVEY UNDER

Application No. 53014 Permit No. 40013
IN NAME OF

JOHN BREEDEN

Surveyed AUG. 4, 1976, by D. NORBY