


T.5N. R.5W. W.M.

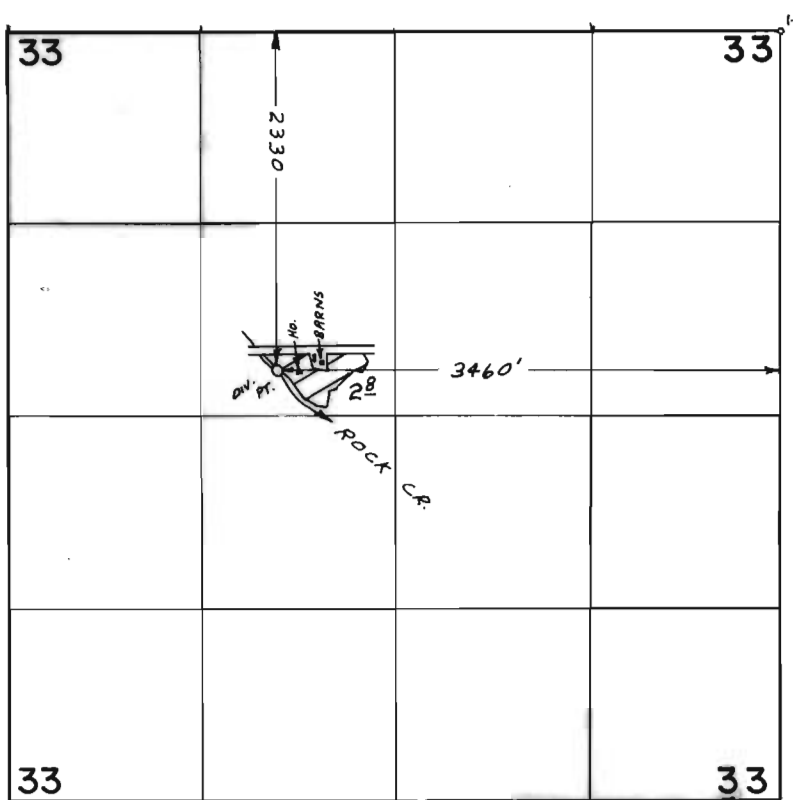

**FINAL PROOF SURVEY**  
UNDER

Application No. 47399... Permit No. 35402...  
IN NAME OF

ANTHONY J. POLOS

Surveyed MAY 26, 1976, by L.H. NUNN