


T.7N. R.2W. W.M.

SEC. 26

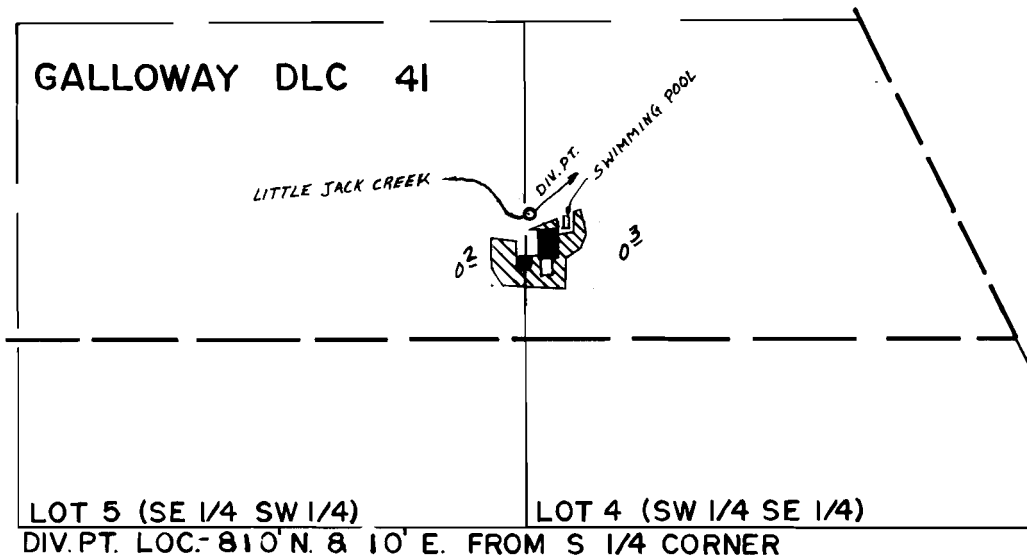

Scale 1" = 500'

FINAL PROOF SURVEY
UNDER

Application No. 50211..... Permit No. 37868
IN NAME OF

RICHARD REED HOLMES

Surveyed July 1, 1976, by L.H. NUNN